

MISSISSIPPI DEPARTMENT OF NATURAL RESOURCES

Bureau of Land and Water Resources

Southport Mall

P.O. Box 10631

Jackson, Mississippi 39209

WATER WELL DRILLERS LOG

**CODED**

F284  
 HARRISON CO.  
 8-26-83

8/26/83 19 Lyman Well Co. Harrison  
 date well completed firm name county well located

LANDOWNER: Kirk Ladner  
Hwy 53  
Gulfport 39503  
 (mailing address)

WELL LOCATION:  
 sec. 24 T. 6 N. R. 12 E  
12 miles <sup>(S)</sup>N of <sup>(W)</sup>Gulfport  
 (distance) (direction) (nearest town)

WELL PURPOSE: home  
 (home, irrigation, municipal, industrial)

WELL COMPLETION DATA:

(1) diameter (inches) 2"

(2) total depth (feet) 383'

(3) static water level (feet) 60' below above top of ground.

(4) casing PVC, 373'  
 (material) (depth)  
2" If telescope see back.  
 (size)

(5) screen 10', 373'  
 (length) (depth to top)  
2", PVC  
 (size) (material)

(6) pump 1/2, 14  
 (HP) (yield gpm)  
electric  
 (type power)

(7) electric log NO  
 (yes or no)  
NO  
 (organization running log)

(8) how well bottom plugged sand  
shark

description of formations encountered	from to	
<u>Red Clay White Clay &amp; fine sand</u>	<u>0</u>	<u>60</u>
<u>sea gravel limestone</u>	<u>60</u>	<u>94</u>
<u>fine sand Blue Clay</u>	<u>94</u>	<u>160</u>
<u>Blue Clay</u>	<u>160</u>	<u>296</u>
<u>Blue Clay &amp; wood</u>	<u>296</u>	<u>340</u>
<u>medium to good sand</u>	<u>340</u>	<u>383</u>


DRILLERS REMARKS: \_\_\_\_\_

DEPT. OF NATURAL RESOURCES  
 BUREAU OF LAND & WATER RESOURCES

APR 28 1984  
**RECEIVED**

If well telescopes please sketch and show depths.

GROUND LEVEL

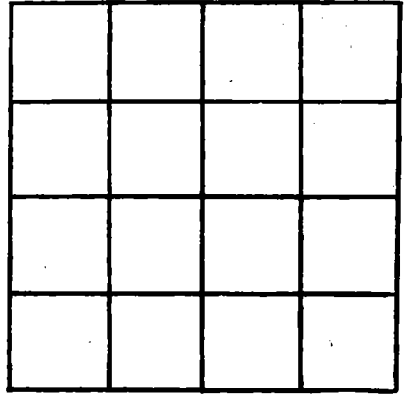

SECTION \_\_\_\_\_

Please Indicate well location X.

ADDITIONAL INFORMATION

If more than one screen,  
show locations of each on sketch.