

MISSISSIPPI DEPARTMENT OF NATURAL RESOURCES

Bureau of Land and Water Resources

Southport Mall

P.O. Box 10631

Jackson, Mississippi 39209

WATER WELL DRILLERS LOG

**CODED**

F285  
 HARRISON  
 10-15-83

10/15/83 19 Lyman Well Co. Harrison  
 date well completed firm name county well located

LANDOWNER Robert Caylor  
Henkle Rd  
Saucier 39574  
 (mailing address)

description of formations encountered	from	to
White clay	0	20
yellow sand	20	80
Blue clay	80	150
Fine sand	150	180
clay	180	245
Good sand	245	270

WELL LOCATION:  
 sec. 14 T. 6 N. R. 12 E.  
6 miles SE of Saucier  
 (distance) (direction) (nearest town)

WELL PURPOSE: Home  
 (home, irrigation, municipal, industrial)

WELL COMPLETION DATA:

(1) diameter (inches) 2"

(2) total depth (feet) 280'

(3) static water level (feet) 68' below above top of ground.

(4) casing PVC, 270'  
 (material) (depth)  
2" If telescope see back.  
 (size)

(5) screen 10', 270'  
 (length) (depth to top)  
2", PVC  
 (size) (material)

(6) pump 1 (HP), 11 (yield gpm)  
electric  
 (type power)

(7) electric log NO  
 (yes or no)  
NO  
 (organization running log)

(8) how well bottom plugged sand  
chalk

DEPT. OF NATURAL RESOURCES  
 BUREAU OF LAND & WATER RESOURCES


APR 30 1984

**RECEIVED**

DRILLERS REMARKS:

If well telescopes please sketch and show depths.

GROUND LEVEL

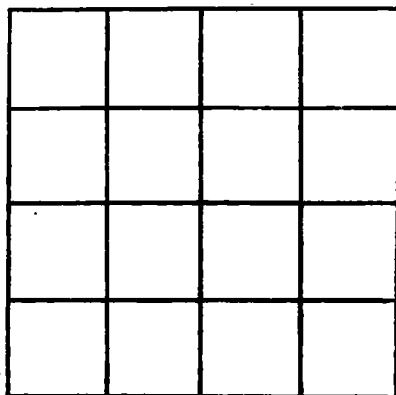

SECTION \_\_\_\_\_

Please indicate well location X.

ADDITIONAL INFORMATION

If more than one screen, show locations of each on sketch.