

MISSISSIPPI DEPARTMENT OF NATURAL RESOURCES

Bureau of Land and Water Resources

Southport Mall

P.O. Box 10631

Jackson, Mississippi 39209

WATER WELL DRILLERS LOG

CODED

F286
 HARRISON CO
 10-21-83

10/21/83
 date well completed

Lyman Well Co.
 firm name

Harrison
 county well located

LANDOWNER: Jody Thorgan
 Laurel Lyman Rd

(mailing address)

WELL LOCATION:

sec. 6 T. 6 N. R. 12 E.
 20 miles NW of Gulfport
 (distance) (direction) (nearest town)

WELL PURPOSE: None
 (home, irrigation, municipal, industrial)

WELL COMPLETION DATA:

- (1) diameter (inches) 2"
- (2) total depth (feet) 538'
- (3) static water level (feet) 63' below above top of ground.
- (4) casing PVC, 528'
 (material) (depth)
2"
 (size) if telescope see back.
- (5) screen 10', 528'
 (length) (depth to top)
2", PVC
 (size) (material)
- (6) pump 1, 8
 (HP) (yield gpm)
electric
 (type power)
- (7) electric log No
 (yes or no)
No
 (organization running log)
- (8) how well bottom plugged sand
shark

description of formations encountered	from	to
Red white clay Gumbo	0	180
medium to fine sand last 4 feet is brook	180	205
Blue Clay	205	480
Mediocre Sand	480	516
Brook sand	516	538


DRILLERS REMARKS:

DEPT. OF NATURAL RESOURCES
 BUREAU OF LAND & WATER RESOURCES

APR 26 1984
 RECEIVED

If well telescopes please sketch and show depths.

GROUND LEVEL

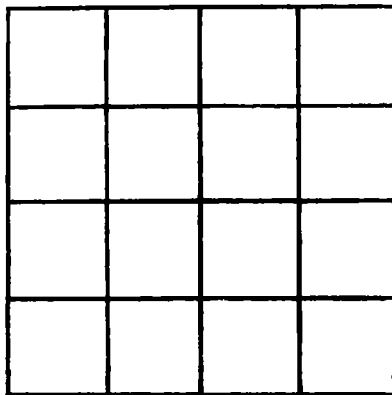

SECTION _____

Please indicate well location X.

ADDITIONAL INFORMATION

If more than one screen, show locations of each on sketch.