

MISSISSIPPI DEPARTMENT OF NATURAL RESOURCES

Bureau of Land and Water Resources

Southport Mall

P.O. Box 10631

Jackson, Mississippi 39209

WATER WELL DRILLERS LOG

F 290
HARRISON
4-23-84

CODED

4/23 1984 Braden Pumps Well Serv Harrison
date well completed firm name county well located

LANDOWNER: Ricky West
Menonite Rd.
Gulfport Ms 39503
(mailing address)

description of formations encountered	from to	
green clay	0	80
sand clay	80	100
green clay	100	120
clay + sand	120	140
clay + sand	140	160
green clay	160	300
hard + clay	300	360
sand	360	400

WELL LOCATION:
sec. 21 T. 6 S. R. 12 E. S. 3
3 miles So of Liza
(distance) (direction) (nearest town)

WELL PURPOSE: HOME
(home, irrigation, municipal, industrial)

WELL COMPLETION DATA:
(1) diameter (inches) 4"
(2) total depth (feet) 400
(3) static water level (feet) 50 below top of ground.
(4) casing PVC 370 (material), (depth)
4" (size) If telescope see back.
(5) screen 10' 370 (length), (depth to top)
4" PVC (size), (material)
(6) pump 1 70 (HP), (yield gpm)
230V (type power)
(7) electric log NO (yes or no)
(organization running log)

(8) how well bottom plugged PVC sandbar

DRILLERS REMARKS: 20' tailpipe


DEPT. OF NATURAL RESOURCES
BUREAU OF LAND & WATER RESOURCES

MAY 21 1984

RECEIVED

If well telescopes please sketch and show depths.

GROUND LEVEL

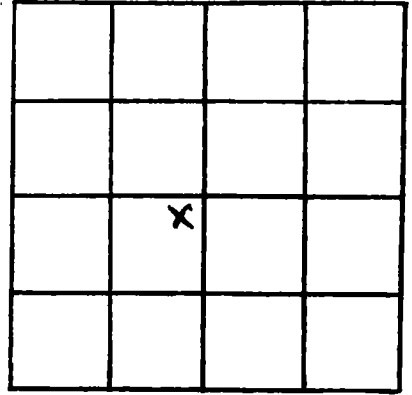

SECTION 21

Please indicate well location X.

ADDITIONAL INFORMATION

If more than one screen, show locations of each on sketch.