

MISSISSIPPI DEPARTMENT OF NATURAL RESOURCES

Bureau of Land and Water Resources

Southport Mall

P.O. Box 10631

(CODE)

Jackson, Mississippi 39209

WATER WELL DRILLERS LOG

F 291  
HARRISON  
3-31-84

3-31 1984 date well completed      McNeil Wells firm name      Harrison county well located

LANDOWNER: Henry Seidigh  
Rt. 2 Box 109  
Lauderdale Ms.  
(mailing address)

WELL LOCATION:  
sec. 1 T 6 N R 12 E  
5 miles S of Lauderdale  
(distance) (direction) (nearest town)

WELL PURPOSE: home  
(home, irrigation, municipal, industrial)

WELL COMPLETION DATA:  
(1) diameter (inches) 2"  
(2) total depth (feet) 500  
(3) static water level (feet) 20 (below above top of ground.)  
(4) casing Ach. KIPK 490'  
(size) if telescope see back.  
(5) screen 10' 490'  
(length) (depth to top)  
2" Ach. SDVC  
(size) (material)  
(6) pump 1 (HP) 9 (yield gpm)  
electric  
(type power)  
(7) electric log no  
(yes or no)

(organization running log)  
(8) how well bottom plugged sand seal

description of formations encountered	from	to
sand	0	60
med-sand	60	100
myrd	100	160
sand	160	265
med-sand	265	300
sand	300	340
med-sand	340	450
f. sand - med	450	470
sand	470	485
C.B. sand	485	500

DEPT. OF NATURAL RESOURCES  
BUREAU OF LAND & WATER RESOURCES


JUN - 1 1984

RECEIVED

DRILLERS REMARKS:

If well telescopes please sketch and show depths.

GROUND LEVEL

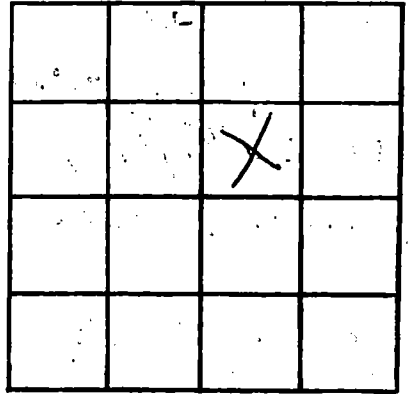

SECTION \_\_\_\_\_

Please indicate well location X.

ADDITIONAL INFORMATION

Lined area for additional information.

If more than one screen, show locations of each on sketch.