

MISSISSIPPI DEPARTMENT OF NATURAL RESOURCES

Bureau of Land and Water Resources

Southport Mall

P.O. Box 10631

CODED

Jackson, Mississippi 39209

WATER WELL DRILLERS LOG

HARRISON
F 296
2/22/84

2/22/84 19 date well completed
Lyman Well Co. firm name
Harrison county well located

LANDOWNER: Helen Sadner

description of formations encountered from to

Rt. 1, Box 362
Saucier 39574
(mailing address)

Red & White Clay	0	100
Fine Sand & Clay	100	150
Mixed	150	
Coarse Sand	150	170

WELL LOCATION:

sec. 29 T. 6 N. R. 12 E.
29 miles N/W of Cot.
(distance) (direction) (nearest town)

CODED

WELL PURPOSE:

home
(home, irrigation, municipal, industrial)

WELL COMPLETION DATA:

- (1) diameter (inches) 2"
- (2) total depth (feet) 170'
- (3) static water level (feet) 60' below top of ground.
- (4) casing PVC, 160' (material) (depth)
2" (size) if telescope see back.
- (5) screen 10', 160' (length) (depth to top)
2" (size) PVC (material)
- (6) pump 1 (HP) 12 (yield gpm)
Elec. (type power)
- (7) electric log No (yes or no)
No (organization running log)
- (8) how well bottom plugged Sand Shank

DRILLERS REMARKS:


DEPT. OF NATURAL RESOURCES
BUREAU OF LAND & WATER RESOURCES

SEP - 5 1984

RECEIVED

If well telescopes please sketch and show depths.

GROUND LEVEL

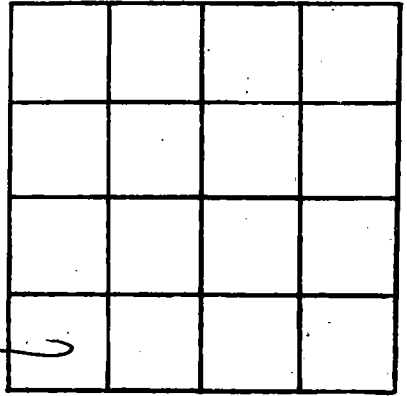

SECTION 29

Please indicate well location X.

ADDITIONAL INFORMATION

If more than one screen, show locations of each on sketch.