

MISSISSIPPI DEPARTMENT OF NATURAL RESOURCES

Bureau of Land and Water Resources

Southport Mall

P.O. Box 10631

Jackson, Mississippi 39209

WATER WELL DRILLERS LOG

CODED

HARRISON
F 297
5/10/84

5/10/84 date well completed
Lyman Well Co firm name
Harrison county well located

LANDOWNER: Andy Patton

description of formations encountered from to

Rt. 2, Box 129
Gulfport, 39503
(mailing address)

yellow sand	0	40
yellow clay	40	80
fine sand	80	120
blue clay	120	153
Good shell	153	173

WELL LOCATION:

sec. 8 T. 6 N R. 12 E
29 miles N/W of GPT
(distance) (direction) (nearest town)

WELL PURPOSE: none
(home, irrigation, municipal, industrial)

WELL COMPLETION DATA:

CODED

- (1) diameter (inches) 2"
- (2) total depth (feet) 173'
- (3) static water level (feet) 60' below top of ground.
- (4) casing PVC 163' (material) (depth)
2" (size) if telescope see back.
- (5) screen 10' 163' (length) (depth to top)
2" PVC (size) (material)
- (6) pump 1/2 14 (HP) (yield gpm)
electric (type power)
- (7) electric log No (yes or no)
No (organization running log)
- (8) how well bottom plugged sand shark

DRILLERS REMARKS:


DEPT. OF NATURAL RESOURCES
BUREAU OF LAND & WATER RESOURCES

SEP - 5 1984

RECEIVED

If well telescopes please sketch and show depths.

GROUND LEVEL

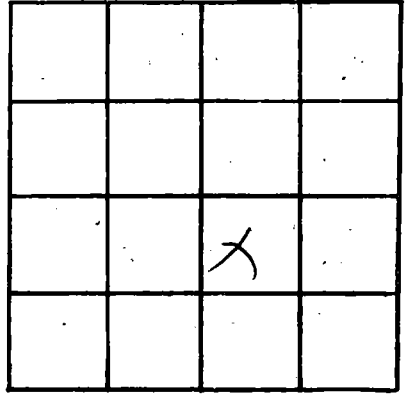

SECTION 8

Please indicate well location X.

ADDITIONAL INFORMATION

If more than one screen, show locations of each on sketch.