

MISSISSIPPI DEPARTMENT OF NATURAL RESOURCES

Bureau of Land and Water Resources

Southport Mall

P.O. Box 10631

CODED

Jackson, Mississippi 39209

WATER WELL DRILLERS LOG

HARRISON  
F299 G406  
1/25/84

1/25/84 date well completed  
Lyman Well Co firm name  
Harrison county well located

LANDOWNER: South Central Bell  
Hwy 53 Office  
Gulfport, MS 39503  
(mailing address)

Description of formations encountered	from	to
Red Clay & Gravel	0	75'
Red Clay & Green Gumbo	75	150
Green Gumbo	150	250
White Sand & Clay	250	340
Blue Clay	340	440
Good Sand	440	516

WELL LOCATION:  
sec. 30 T. 6 N. R. 12 E  
12 miles N of Gulfport  
(distance) (direction) (nearest town)

WELL PURPOSE: office  
(home, irrigation, municipal, industrial)

WELL COMPLETION DATA:

(1) diameter (inches) 4"

(2) total depth (feet) 516'

(3) static water level (feet) 77' below top of ground.

(4) casing PVC, 496' (depth)  
4" (size) if telescope see back.

(5) screen 20' (length), 496' (depth to top)  
4" (size), PVC (material)

(6) pump 2 (HP), 45 (yield gpm)  
electric (type power)

(7) electric log No (yes or no)  
No (organization running log)

(8) how well bottom plugged sand shark

CODED

DEPT. OF NATURAL RESOURCES  
BUREAU OF LAND & WATER RESOURCES


SEP - 5 1984

RECEIVED

DRILLERS REMARKS:

If well telescopes please sketch and show depths.

GROUND LEVEL

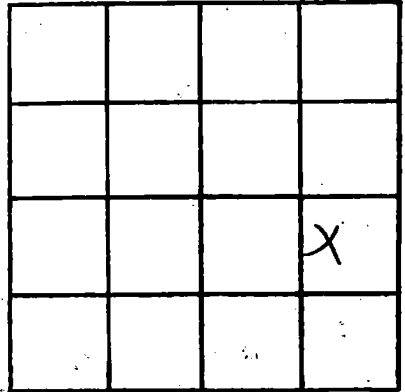

SECTION 30

Please indicate well location X.

ADDITIONAL INFORMATION

If more than one screen,  
show locations of each on sketch.