

MISSISSIPPI DEPARTMENT OF NATURAL RESOURCES

Bureau of Land and Water Resources

Southport Mall

P.O. Box 10631

CODED

Jackson, Mississippi 39209

WATER WELL DRILLERS LOG

HARRISON  
F 300  
4/14/84

4/14/84 19 Syman Well Co. Harrison  
date well completed firm name county well located

LANDOWNER: John Scarborough  
Rt. 1, Box 758  
Sauvier 39574  
(mailing address)

| description of formations encountered | from to |     |
|---------------------------------------|---------|-----|
|                                       |         |     |
| Top soil                              | 0       | 5   |
| yellow & white clay                   | 5       | 25  |
| blue clay                             | 25      | 290 |
| fine sand                             | 290     | 305 |

WELL LOCATION:  
sec. 25 T. 6 N. R. 12 E  
S. W. W.  
miles of (distance) (direction) (nearest town)

WELL PURPOSE: Home  
(home, irrigation, municipal, industrial)

CODED

- WELL COMPLETION DATA:
- (1) diameter (inches) 2"
  - (2) total depth (feet) 305'
  - (3) static water level (feet) 47' below top of ground.
  - (4) casing PVC, 295'  
(material) (depth)  
2" if telescope see back.  
(size)
  - (5) screen 10', 295'  
(length) (depth to top)  
2", PVC  
(size) (material)
  - (6) pump 1 (HP), (yield gpm)  
electric  
(type power)
  - (7) electric log NO  
(yes or no)  
NO  
(organization running log)
  - (8) how well bottom plugged sand  
shark

DEPT. OF NATURAL RESOURCES  
BUREAU OF LAND & WATER RESOURCES


SEP - 5 1984

RECEIVED

DRILLERS REMARKS: \_\_\_\_\_

If well telescopes please sketch and show depths.

GROUND LEVEL

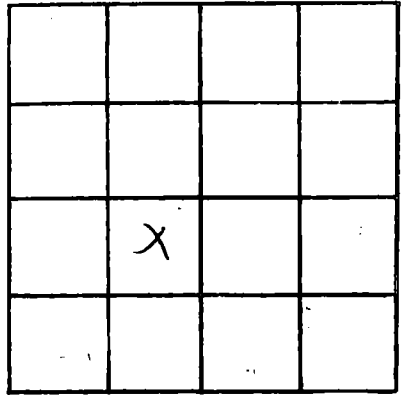

SECTION 25

Please indicate well location X.

ADDITIONAL INFORMATION

If more than one screen,  
show locations of each on sketch.