

MISSISSIPPI DEPARTMENT OF NATURAL RESOURCES

Bureau of Land and Water Resources

Southport Mall

P.O. Box 10631

Jackson, Mississippi 39209

WATER WELL DRILLERS LOG

CODED

HARRISON
F 301
3/28/84

3/28/84
date well completed

Lyman Well Co.
firm name

Harrison
county well located

LANDOWNER: Sammy Peterman
Saucier 39574
(mailing address)

Description of formations encountered	from to	
Top soil	0	5
yellow clay	5	12
sand	12	40
Redd clay	40	240
sand & gravel	240	280

WELL LOCATION:
sec 25 T N R E
20 miles W of Dudox
(distance) (direction) (nearest town)

WELL PURPOSE: home
(home, irrigation, municipal, industrial)

WELL COMPLETION DATA:

(1) diameter (inches) 2"

(2) total depth (feet) 280'

(3) static water level (feet) 6 below top of ground

(4) casing PVC, 270'
(material) (depth)
2" If telescope see back.
(size)

(5) screen 10', 270'
(length) (depth to top)
2", PVC
(size) (material)

(6) pump 1, 12
(HP) (yield gpm)
electric
(type power)

(7) electric log No
(yes or no)
No
(organization running log)

(8) how well bottom plugged BPU

CODED


DEPT. OF NATURAL RESOURCES
BUREAU OF LAND & WATER RESOURCES

SEP - 5 1984
RECEIVED

DRILLERS REMARKS:

If well telescopes please sketch and show depths.

GROUND LEVEL

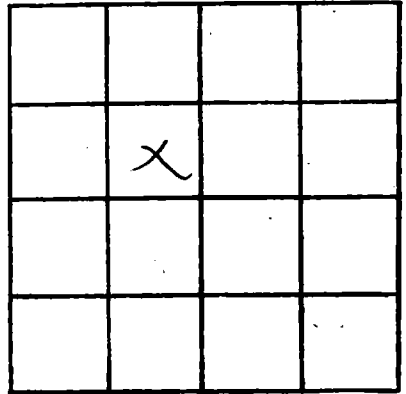

SECTION 25

Please indicate well location X.

ADDITIONAL INFORMATION

If more than one screen,
show locations of each on sketch.