

MISSISSIPPI DEPARTMENT OF NATURAL RESOURCES

Bureau of Land and Water Resources

Southport Mall

P.O. Box 10631

CODED

Jackson, Mississippi 39209

WATER WELL DRILLERS LOG

HARRISON  
F-302  
2/14/84

2/16/84 19 Lyman Well Co. Harrison  
date well completed firm name county well located

LANDOWNER: Raymond Lee  
Old Hwy 49  
Gulfport 39503  
(mailing address)

description of formations encountered	from	to
Red Sand	0	80
White & Grey Clay	80	140
Blue Clay	140	290
Five Sand	290	340
Blue Clay	340	463
Good Sand	463	500

WELL LOCATION:  
sec 29 T 6 N R 12 E  
9 miles (distance) N of Gpt. (direction) (nearest town)

WELL PURPOSE: home  
(home, irrigation, municipal, industrial)

WELL COMPLETION DATA:

(1) diameter (inches) 4x2

(2) total depth (feet) 500'

(3) static water level (feet) 70' below above top of ground.

(4) casing PVC 480'  
(material) (depth)  
4x2 (size) If telescope see back.

(5) screen 20' 480'  
(length) (depth to top)  
2" PVC  
(size) (material)

(6) pump 2 50.  
(HP) (yield gpm)  
Electric  
(type power)

(7) electric log NO  
(yes or no)  
NO  
(organization running log)

(8) how well bottom plugged sand  
Shark.

CODED

BUREAU OF NATURAL RESOURCES  
BUREAU OF LAND & WATER RESOURCES


SEP - 5 1984

RECEIVED

DRILLERS REMARKS:

If well telescopes please sketch and show depths.

GROUND LEVEL

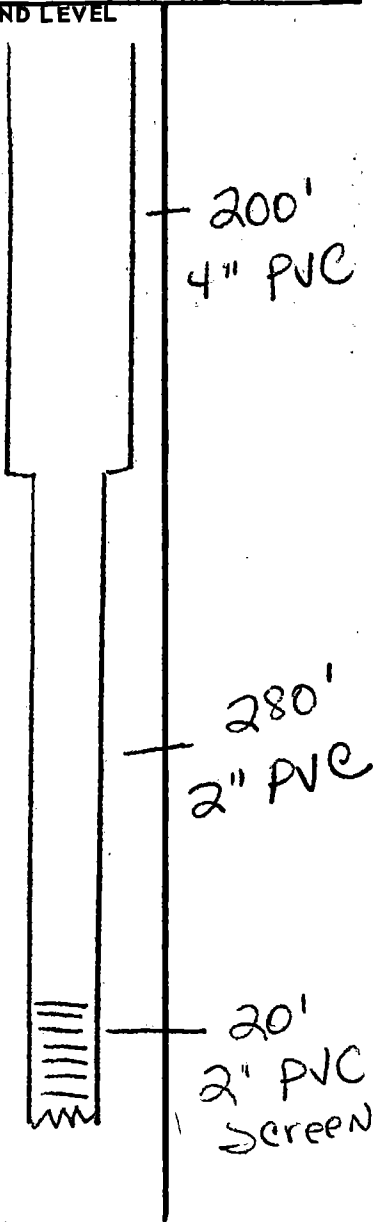

		X	

SECTION 29

Please indicate well location X.

ADDITIONAL INFORMATION

---

---

If more than one screen, show locations of each on sketch.