

MISSISSIPPI DEPARTMENT OF NATURAL RESOURCES

Bureau of Land and Water Resources

Southport Mall

P.O. Box 10631

CODED

Jackson, Mississippi 39209

WATER WELL DRILLERS LOG

F 311  
 Harrison  
 8-20-84


8/20/84 19 Lyman Well Co. Harrison  
 date well completed firm name county well located

LANDOWNER	description of formations encountered	from	to
<u>Curtis Prestwood</u> <u>Shaw Rd</u>	<u>yellow clay</u>	<u>0</u>	<u>7</u>
<u>Gulfport, Ms</u> (mailing address)	<u>white clay</u>	<u>8</u>	<u>19</u>
WELL LOCATION: sec. <u>10</u> T. <u>6</u> N. R. <u>12</u> E <u>11</u> miles <u>N</u> of <u>gpt</u> (distance) (direction) (nearest town)	<u>blue clay</u>	<u>20</u>	<u>90</u>
WELL PURPOSE: <u>home</u> (home, irrigation, municipal, industrial)	<u>yellow sand</u>	<u>91</u>	<u>107</u>
WELL COMPLETION DATA: (1) diameter (inches) <u>2"</u>			
(2) total depth (feet) <u>107'</u>			
(3) static water level (feet) <u>6'</u> <u>below</u> above top of ground.			
(4) casing <u>PVC</u> , <u>97'</u> (material), (depth) <u>2"</u> If telescope see back. (size)			
(5) screen <u>10'</u> , <u>97'</u> (length), (depth to top) <u>2'</u> , <u>PVC</u> (size), (material)			
(6) pump <u>1</u> , <u>18</u> (HP), (yield gpm) <u>electric</u> (type power)			
(7) electric log <u>No</u> (yes or no) <u>No</u> (organization running log)			
(8) how well bottom plugged <u>sand</u> <u>Shack</u>			
DRILLERS REMARKS:			

DEPT. OF NATURAL RESOURCES  
 BUREAU OF LAND & WATER RESOURCES  
 DEC 10 1984  
 RECEIVED

If well telescopes please sketch and show depths.

GROUND LEVEL

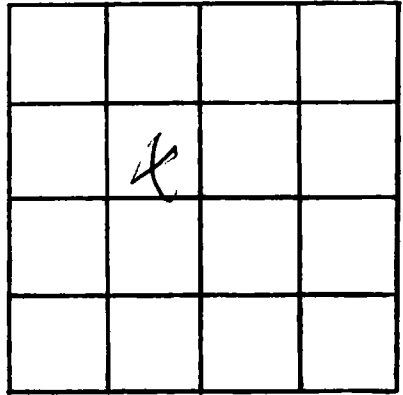

SECTION 10

Please indicate well location X.

ADDITIONAL INFORMATION

If more than one screen, show locations of each on sketch.