

Harrison  
F316  
2/22/85

MISSISSIPPI DEPARTMENT OF NATURAL RESOURCES  
Bureau of Land and Water Resources  
Southport Mall  
P.O. Box 10631  
Jackson, Mississippi 39209  
WATER WELL DRILLERS LOG

CODED

2/22/85 19 Lyman Well Co Harrison  
date well completed firm name county well located

LANDOWNER: Calvin Coleman  
Rt. 11, Box 416  
Gulfport, Miss 39503  
(mailing address)

description of formations encountered	from	to
WHITE CLAY	0	40
Red sand	40	80
Blue clay	80	160
white sand	160	260
Blue clay	260	325
Blue sand case	325	366

WELL LOCATION:  
sec. 26 T. 6 N R. 12 E  
9 miles N.W. of Gulfport  
(distance) (direction) (nearest town)

WELL PURPOSE: Home  
(home, irrigation, municipal, industrial)

WELL COMPLETION DATA:

- (1) diameter (inches) 2"
- (2) total depth (feet) 366'
- (3) static water level (feet) 66 below above top of ground.
- (4) casing PVC 356' (material) (depth)  
2" (size) if telescope see back.
- (5) screen 10' 356' (length) (depth to top)  
2" PVC (size) (material)
- (6) pump N/A (HP) (yield gpm)

(type power)  
(7) electric log No (yes or no)  
(organization running log)

(8) how well bottom plugged sand  
shark

DRILLERS REMARKS:


CODED

RECEIVED  
MAY 24 1985

Department of Natural Resources  
Bureau of Land & Water Resources

If well telescopes please  
sketch and show depths.

**GROUND LEVEL**

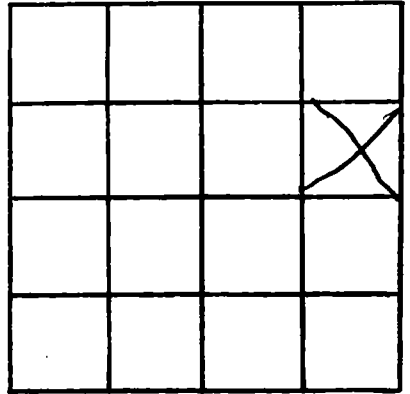

**SECTION** 26

**Please indicate well location X.**

**ADDITIONAL INFORMATION**

A series of 20 horizontal lines for writing additional information.

If more than one screen,  
show locations of each on sketch.