

MISSISSIPPI DEPARTMENT OF NATURAL RESOURCES

Bureau of Land and Water Resources

Southport Mall

P.O. Box 10631

Jackson, Mississippi 39209

WATER WELL DRILLERS LOG

**CODED**

Harrison
F320
4/28/85

4-28-

1985

Mc Gill Well Works

Harrison

date well completed

firm name

county well located

LANDOWNER: Super B Construction  
Red Creek Estates  
Gulfport Ms.  
 (mailing address)

WELL LOCATION:  
 sec. 33 T. 6 N. R. 12 E  
12 miles NW of Gulfport  
 (distance) (direction) (nearest town)

WELL PURPOSE:  
 (home, irrigation, municipal, industrial)

WELL COMPLETION DATA:

- (1) diameter (inches) 2"
- (2) total depth (feet) 420'
- (3) static water level (feet) 20' <sup>below</sup> <sub>above</sub> top of ground.
- (4) casing Pvc Sch 40, 410'  
 (material) (depth)  
 (size) if telescope see back.
- (5) screen 10', 410'  
 (length) (depth to top)  
2", Sch 80 - 6 slot  
 (size) (material)
- (6) pump 1 9  
 (HP) (yield gpm)  
Electric  
 (type power)
- (7) electric log                       
 (yes or no)  
    
 (organization running log)
- (8) how well bottom plugged Sand  
SHARK

Description of formations encountered	from	to
Mud	0	20
Mud/Sand	20	40
Mud <b>CODED</b>	40	80
Mud/Sand	80	100
Sand/Mud	100	120
Mud	120	220
Mud/Sand	220	240
Mud	240	260
Mud/Sand	260	280
Mud	280	380
Mud/Sand	380	400
Sand	400	420

**RECEIVED**


JUN - 1 1985

DRILLERS REMARKS:

Department of Natural Resources  
 Bureau of Land & Water Resources

If well telescopes please sketch and show depths.

GROUND LEVEL

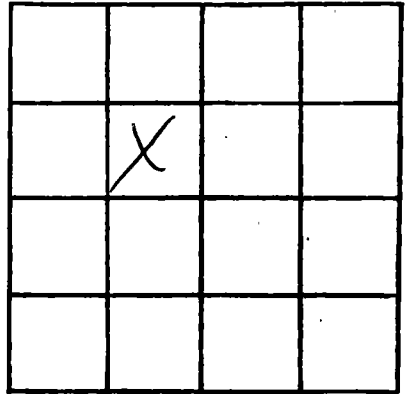

SECTION \_\_\_\_\_

Please indicate well location X.

ADDITIONAL INFORMATION

If more than one screen, show locations of each on sketch.