

MISSISSIPPI DEPARTMENT OF NATURAL RESOURCES
Bureau of Land and Water Resources
 Southport Mall
 P.O. Box 10631
 Jackson, Mississippi 39209
WATER WELL DRILLERS LOG

CODED

Harrison
F321
4/29/85

4-29 1985 Mc Hill Well works Harrison
 date well completed firm name county well located

LANDOWNERS: Super B Construction
Reed Creek Estates
Shelfport, Ms. 39501
 (mailing address)

WELL LOCATION:
 sec. 33 T. 6 N. R. 12 E.
12 miles NW of Shelfport
 (distance) (direction) (nearest town)

WELL PURPOSE:
 (home, irrigation, municipal, industrial)

WELL COMPLETION DATA:

(1) diameter (inches) 2"

(2) total depth (feet) 420'

(3) static water level (feet) 20' ^{below} _{above} top of ground.

(4) casing Pvc. Sch. 40 410'
 (material) (depth)

 If telescope see back.
 (size)

(5) screen 10' 410'
 (length) (depth to top)

2" Sch. 80 6 plot
 (size) (material)

(6) pump 1 9
 (HP) (yield gpm)

FLCET
 (type power)

(7) electric log
 (yes or no)

 (organization running log)

(8) how well bottom plugged SAND
SHARK


Description of formations encountered	CODED	
	from	to
Mud	0	30
Mud / Sand	30	40
Mud	40	80
Mud / Sand	80	108
Sand / Mud	108	120
Mud	120	220
Mud / Sand	220	248
Mud	248	260
Mud / Sand	260	288
Mud	288	388
Mud / Sand	388	400
Sand	400	420

RECEIVED
 JUN - 7 1985

DRILLERS REMARKS: _____
 Department of Natural Resources
 Bureau of Land & Water Resources

If well telescopes please sketch and show depths.

GROUND LEVEL

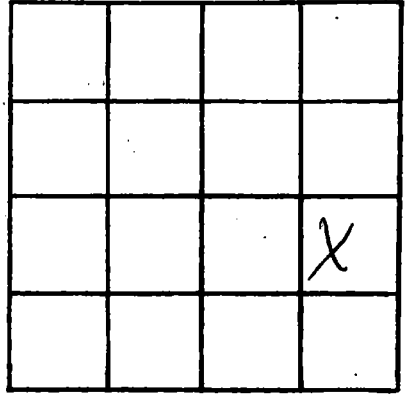

SECTION _____

Please indicate well location X.

ADDITIONAL INFORMATION

If more than one screen, show locations of each on sketch.