

MISSISSIPPI DEPARTMENT OF NATURAL RESOURCES
Bureau of Land and Water Resources
 Southport Mall
 P.O. Box 10631
 Jackson, Mississippi 39209
WATER WELL DRILLERS LOG

CODED

HARRISON
F 323

3/19/85
 date well completed

Lyman Well
 firm name

Harrison
 county well located

LANDOWNER: Alfred W. Fellows
Rt. 2, Box 309-G
Saucier, MS 39574
 (mailing address)

Description of formations encountered	from	to
<u>white clay</u>	<u>0</u>	<u>100</u>
<u>blue clay</u>	<u>140</u>	<u>165</u>
<u>coarse sand</u>	<u>165</u>	<u>194</u>

WELL LOCATION:
 sec. 32 T. 6 N. R. 12 E.
4 miles South of Syzona
 (distance) (direction) (nearest town)

CODED

WELL PURPOSE: Home
 (home, irrigation, municipal, industrial)

- WELL COMPLETION DATA:**
- (1) diameter (inches) 3 4"
 - (2) total depth (feet) 194'
 - (3) static water level (feet) 40' below top of ground
 - (4) casing PVC, 184'
 (material) (depth)
4" if telescope see back.
 (size)
 - (5) screen 10', 184'
 (length) (depth to top)
2", PVC
 (size) (material)
 - (6) pump 1, 30
 (HP) (yield gpm)
electric
 (type power)
 - (7) electric log No
 (yes or no)
No
 (organization running log)
 - (8) how well bottom plugged sand
shark


RECEIVED
 AUG 20 1985

Department of Natural Resources
 Bureau of Land & Water Resources

DRILLERS REMARKS:

If well telescopes please sketch and show depths.

GROUND LEVEL

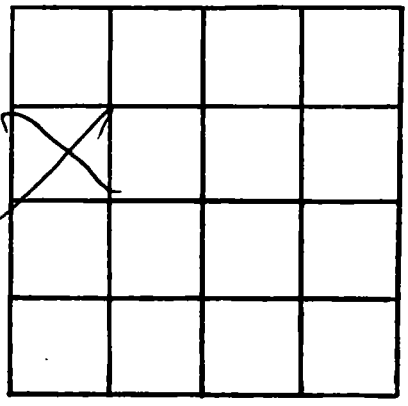

SECTION 32

Please indicate well location X.

ADDITIONAL INFORMATION

A series of horizontal lines for writing additional information.

If more than one screen, show locations of each on sketch.