

MISSISSIPPI DEPARTMENT OF NATURAL RESOURCES

Bureau of Land and Water Resources

Southport Mall

P.O. Box 10631

Jackson, Mississippi 39209

WATER WELL DRILLERS LOG

CODED

Harrison
F 326

11-26-85
date well completed

R Moore
firm name

Harrison
county well located

LANDOWNER: P. Homsey
CCRD

1121 N A, MS
(mailing address)

WELL LOCATION:

sec. 21 T-6 N R-12 E
1/2 miles N of Mendenhall Church
(distance) (direction) (nearest town)

WELL PURPOSE:

(home, irrigation, municipal, industrial)

WELL COMPLETION DATA:

- (1) diameter (inches) 2"
- (2) total depth (feet) 410'
- (3) static water level (feet) 2' below top of ground.
- (4) casing PVC, 410' (material) (depth)
(size) If telescope see back.
- (5) screen 2x10', 410' (length) (depth to top)
2" PVC (size) (material)
- (6) pump (HP) (yield gpm)
(type power)
- (7) electric log (yes or no)
(organization running log)
- (8) how well bottom plugged PVC

description of formations encountered

from to

TOP Soil	0	15
Red Sand & Gravel	15	25
Red weathered Clay	25	60
Blue Clay	60	380
med S m & l	380	400
Corrosive Sand	400	410

CODED

RECEIVED


JAN 6 1986

Department of Natural Resources
Bureau of Land & Water Resources

DRILLERS REMARKS:

If well telescopes please sketch and show depths.

GROUND LEVEL

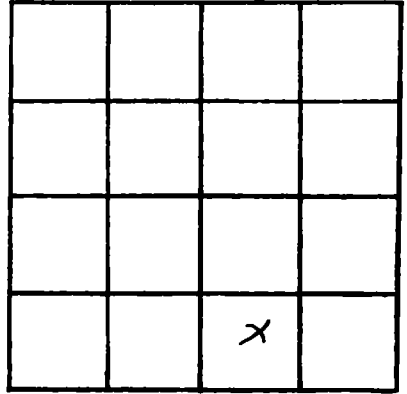

SECTION 21

Please indicate well location X.

ADDITIONAL INFORMATION

If more than one screen,
show locations of each on sketch.