

MISSISSIPPI DEPARTMENT OF NATURAL RESOURCES

Bureau of Land and Water Resources

Southport Mall

P.O. Box 10631

Jackson, Mississippi 39209

WATER WELL DRILLERS LOG

Harrison
F 328
12-11-85?

F328
1-22-86

Cover

12/11/85
date well completed

~~Thomas Well~~
firm name

Harrison
county well located

LANDOWNER: Crown Zellerbach
P.O. Box 2219
Gulfport, MS 39503
(mailing address)

WELL LOCATION:
sec. 24 T 6 N R 12 E
4 miles W of Lyman
(distance) (direction) (nearest town)

WELL PURPOSE: monitor
(home, irrigation, municipal, industrial)

WELL COMPLETION DATA:
(1) diameter (inches) 8x4
(2) total depth (feet) 215'
(3) static water level (feet) 60 below above top of ground.
(4) casing PVC, 205'
(material) (depth)
8x4 If telescope see back.
(size)
(5) screen 10', 205'
(length) (depth to top)
4" PVC
(size) (material)
(6) pump 1 1/2 30
(HP) (yield gpm)
electric
(type power)
(7) electric log yes
(yes or no)
No
(organization running log)
(8) how well bottom plugged sand
shark


description of formations encountered	from	to
Top soil	0	3
yellow clay	3	8
Mixed clay	8	40
yellow oxidized clay	40	60
Blue clay	60	80
yellow clay	80	170
sand	170	215
blue clay	215	538

DRILLERS REMARKS: drilled to 538' pulled back & set at 215'

RECEIVED
APR - 9 1986

Department of Natural Resources
Bureau of Land & Water

If well telescopes please sketch and show depths.

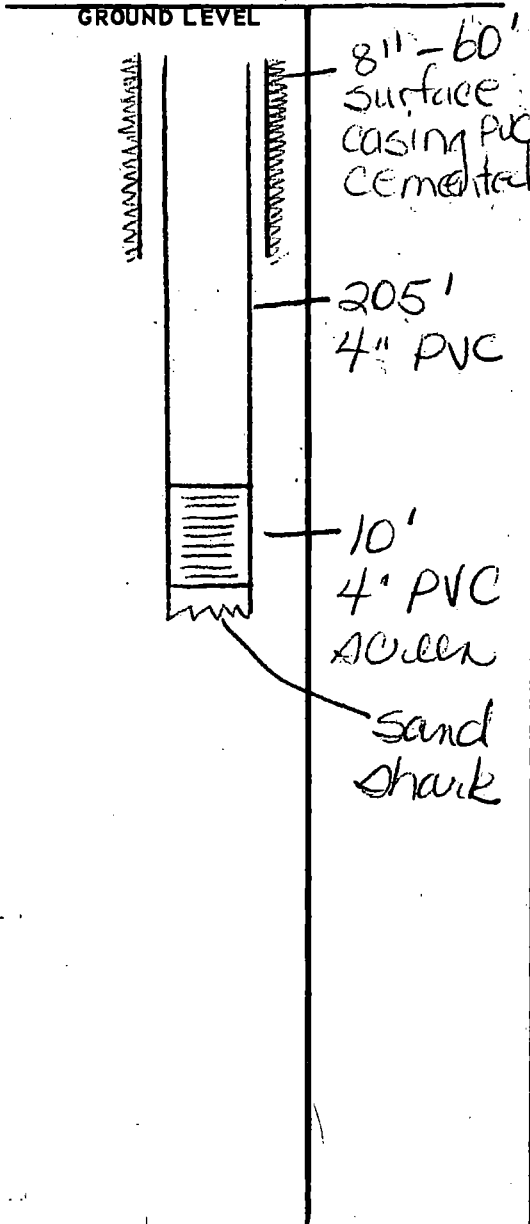

	X		

SECTION 24

Please indicate well location X.

ADDITIONAL INFORMATION

If more than one screen, show locations of each on sketch.