

MISSISSIPPI DEPARTMENT OF NATURAL RESOURCES
Braden Pump & Well Service, Bureau of Land and Water Resources

P.O. Box 10631
 Jackson, Mississippi 39209
CODED
WATER WELL DRILLERS LOG

COUNTY WELL LOCATED
Harrison

WELL NUMBER CODED
F 330

DATE WELL COMPLETED
7-22-87

PERMIT NUMBER
1770 Country Cove

NAME OF DRILLER
Sauget, MS 39574
H & B Drilling Co.

NAME & MAILING ADDRESS OF LANDOWNER
Ernie H Kynard
15370 LIZANA School Rd.
GULFPORT, MS. 39503

WELL LOCATION: SEC TOWNSHIP RANGE
19 6 S 12 W

DISTANCE DIRECTION NEAREST TOWN
2 Miles S of Lizana

OTHER LANDMARK

WELL PURPOSE-Home, Irrigation, Municipal, Industrial, Fish Pond, etc.
Home

PUMP DATA

PUMP TYPE (Circle One):
 Submersible, Turbine, Jet, Flowing Well,
 Other (Describe) _____

POWER TYPE (Circle One):
 Electric, Tractor, Diesel, Gasoline, Butane,
 Other (Describe) _____

Pump Capacity (GPM) No. of Stages Setting Depth
20 *160* FT.

PUMP TEST
 Well yielded *20* GPM with
 a drawdown of _____ ft.
 after _____ hours of pumping

WELL DATA

Well Depth <i>640</i>	Casing Diameter (In.) <i>4" x 2"</i>	Casing Length (Ft.) <i>620</i>
Type of Casing <i>PRC</i>	Hole Depth <i>640</i>	Depth to Static Water Level <i>90</i>

TYPE OF COMPLETION: (Circle One or More):
 Gravel Packed, Underreamed, Telescoped,
 Natural Development, Open Hole, Other

Top of Lap Pipe or Reduction in Casing
 FEET IF TELESCOPED OR MORE THAN ONE SCREEN: USE BACK PAGE

LOG DATA

TYPE OF LOG RUN (Circle One):
 No Log Run,
 Electric, Gamma Ray, Density, Sonic, Neutron,
 Other (Describe) _____

Name of Organization Running Log

SCREEN DATA

Diameter - Inches <i>2"</i>	Length - Feet <i>10</i>	Slot Size - Inches <i>.008</i>
Screen Type <i>PRC W&P</i>	Depth to Bottom - Feet <i>630-10ft tail pipe</i>	

GEOLOGIC DATA (Office Use Only)

Surface Elev.	Geologic Unit	Unit Thickness	Depth to Top
Subs. SWL	Date	Analysis	Aquifer Test

Driller's Remarks

RECEIVED


DESCRIPTION OF FORMATIONS ENCOUNTERED	FROM	TO	FEET CORNS (Continued)	TO
<i>Surface</i>	<i>0</i>	<i>6</i>		
<i>Red Clay</i>	<i>6</i>	<i>26</i>		
<i>Brown Sand</i>	<i>26</i>	<i>46</i>		
<i>White Clay</i>	<i>46</i>	<i>90</i>		
<i>Blue Clay</i>	<i>90</i>	<i>335</i>		
<i>Fine Gray Sand</i>	<i>335</i>	<i>340</i>		
<i>Blue Clay</i>	<i>340</i>	<i>580</i>		
<i>Gray Sand</i>	<i>580</i>	<i>640</i>	<i>+</i>	

AUG 14 1987

Department of Natural Resources
 Bureau of Land & Water Resources

IF MORE SPACE IS NEEDED, USE BACK

If well telescopes please sketch and show depths.

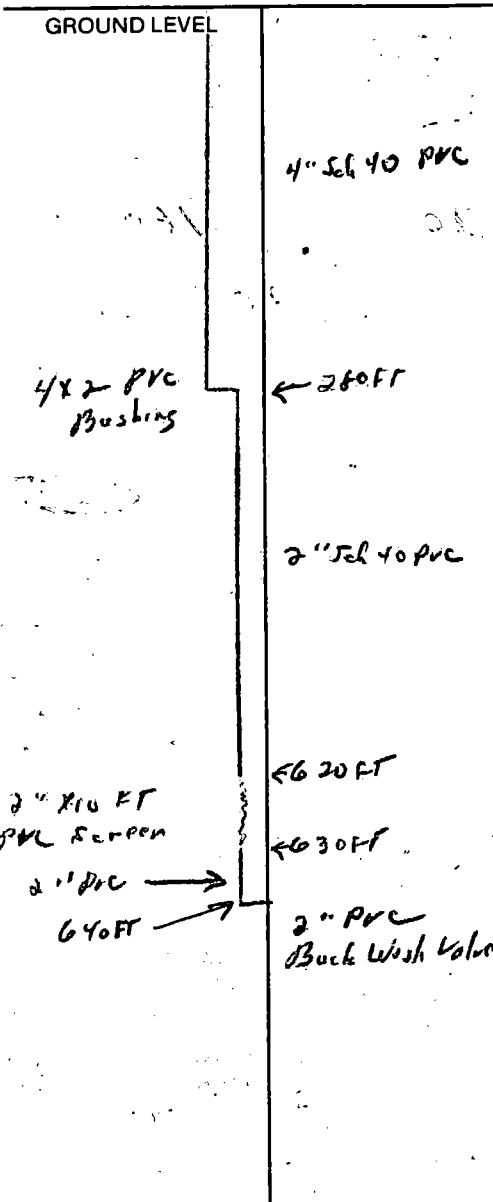

	X		

SECTION 19

Please indicate well location X.

ADDITIONAL INFORMATION

Multiple horizontal lines for additional information.

If more than one screen, show location of each on sketch.