

MISSISSIPPI DEPARTMENT OF NATURAL RESOURCES

Bureau of Land and Water Resources

CODED

P.O. Box 10631

Jackson, Mississippi 39209

WATER WELL DRILLERS LOG

COUNTY WELL LOCATED
Harrison

WELL NUMBER
F 331

PERMIT NUMBER

NAME OF DRILLING FIRM
Lipman Well Co.

DATE WELL COMPLETED
1/5/87

NAME & MAILING ADDRESS OF LANDOWNER
Gene Kelly

P.O. Box 3206

Gulfport, MS 39503

WELL LOCATION: SEC *22* TOWNSHIP *6 N* RANGE *12 E*

DISTANCE *7* Miles DIRECTION *North* of NEAREST TOWN *Long Beach*

OTHER LANDMARK

WELL PURPOSE: *Home, Irrigation, Municipal, Industrial, Fish Pond, etc.*
Home

PUMP DATA

PUMP TYPE (Circle One):
 Submersible Turbine Jet Flowing Well,
Other (Describe) _____

POWER TYPE (Circle One):
 Electric Tractor, Diesel, Gasoline, Butane,
Other (Describe) _____

Pump Capacity (GPM) *18* No. of Stages *11* Setting Depth *189* FT.

PUMP TEST

Well yielded *N/A* GPM with
a drawdown of _____ ft.
after _____ hours of pumping

WELL DATA

Well Depth <i>700'</i>	Casing Diameter (In.) <i>4x2</i>	Casing Length (Ft.) <i>680'</i>
Type of Casing <i>PVC</i>	Hole Depth <i>700'</i>	Depth to Static Water Level <i>138'</i>

TYPE OF COMPLETION: (Circle One or More):
 Gravel Packed, Underreamed, Telescoped,
 Natural Development, Open Hole, Other
(Describe) _____

Top of Lap Pipe or Reduction in Casing

FEET IF TELESCOPED OR MORE THAN ONE SCREEN: USE BACK PAGE

LOG DATA

TYPE OF LOG RUN (Circle One): No Log Run
 Electric, Gamma Ray, Density, Sonic, Neutron,
Other (Describe) _____

Name of Organization Running Log

SCREEN DATA

Diameter - Inches <i>2</i>	Length - Feet <i>20</i>	Slot Size - Inches <i>6</i>
Screen Type <i>PVC</i>	Depth to Bottom - Feet <i>700'</i>	

GEOLOGIC DATA (Office Use Only)

Surface Elev.	Geologic Unit	Unit Thickness	Depth to Top
Subs. SWL	Date	Analysis	Aquifer Test



Driller's Remarks
None

DESCRIPTION OF FORMATIONS ENCOUNTERED	FROM	TO	FORMATIONS (Continued)	FROM	TO
<i>Topsail</i>		<i>1'</i>	RECEIVED AUG 25 1987 Department of Natural Resources Bureau of Land & Water Resources		
<i>Sandy clay</i>	<i>1'</i>	<i>8'</i>			
<i>White & yellow clay</i>	<i>8'</i>	<i>27'</i>			
<i>(gray to blue)</i>	<i>27'</i>	<i>176'</i>			
<i>Sand</i>	<i>176'</i>	<i>191'</i>			
<i>Blue clay</i>	<i>191'</i>	<i>311'</i>			
<i>Sandy clay</i>	<i>311'</i>	<i>335'</i>			
<i>Blue clay</i>	<i>335'</i>	<i>639'</i>			
<i>Screen</i>	<i>639'</i>	<i>700'</i>			

IF MORE SPACE IS NEEDED, USE BACK

If well telescopes please sketch and show depths.

GROUND LEVEL

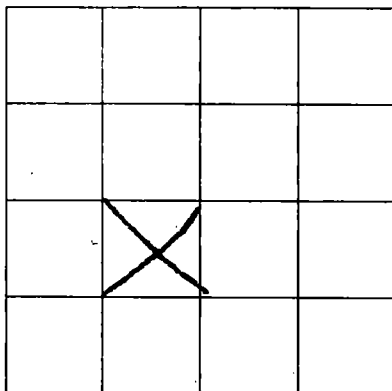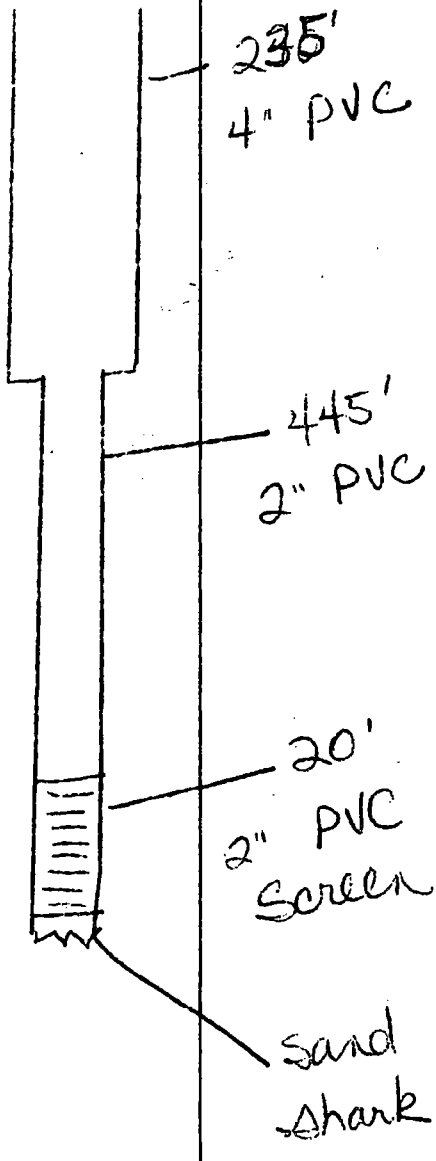

SECTION 22

Please indicate well location X.

ADDITIONAL INFORMATION

If more than one screen, show location of each on sketch.