

30-29-27 89-09-11

MISSISSIPPI DEPARTMENT OF NATURAL RESOURCES

Bureau of Land and Water Resources

P.O. Box 10631

Jackson, Mississippi 39209

WATER WELL DRILLERS LOG

COUNTY WELL LOCATED
Harrison
 WELL NUMBER F333 CODED
 DATE WELL COMPLETED
July 20-89

PERMIT NUMBER
0239
 NAME OF DRILLING FIRM
Ngill

NAME & MAILING ADDRESS OF LANDOWNER Baptist
Michael Memorial Church
County farm
Meat, Ms. 39505
 WELL LOCATION: SEC 2625 TOWNSHIP 6 RANGE 12
 DISTANCE 5 Miles West of Syman
 OTHER LANDMARK
 WELL PURPOSE Home, Irrigation, Municipal, Industrial, Fish Pond, etc.

PUMP DATA
 PUMP TYPE (Circle One):
 Submersible, Turbine, Jet, Flowing Well,
 Other (Describe) _____
 POWER TYPE (Circle One):
 Electric, Tractor, Diesel, Gasoline, Butane,
 Other (Describe) _____ H/P _____
 Pump Capacity (GPM) 28 No. of Stages 14 Setting Depth 147' FT.
 PUMP TEST
 Well yielded 28 GPM with
 a drawdown of 15 ft.
 after 1 hours of pumping

WELL DATA
 Well Depth 520' Casing Diameter (In.) 4" 1/2" Casing Length (Ft.) 20'
 Type of Casing PVC Hole Depth 520' Depth to Static Water Level 100'
 TYPE OF COMPLETION: (Circle One or More):
 Gravel Packed, Underreamed, Telescoped,
 Natural Development, Open Hole, Other
 (Describe) _____
 Top of Lap Pipe or Reduction in Casing
 FEET IF TELESCOPED OR MORE THAN ONE SCREEN: USE BACK PAGE

LOG DATA
 TYPE OF LOG RUN (Circle One):
 No Log Run,
 Electric, Gamma Ray, Density, Sonic, Neutron,
 Other (Describe) _____
 Name of Organization Running Log _____

SCREEN DATA
 Diameter - Inches 2" Length - Feet 20' Slot Size - Inches .0006
 Screen Type PVC Depth to Bottom - Feet 520'

GEOLOGIC DATA (Office Use Only)

Surface Elev.	Geologic Unit	Unit Thickness	Depth to Top
Subs. SWL	Date	Analysis	Aquifer Test

Driller's Remarks


DESCRIPTION OF FORMATIONS ENCOUNTERED	FROM	TO
mud	0	10
sand	10	40
mud	40	120
sand	120	130
mud	130	140
sand	140	180
mud	180	190
sand	190	210
mud	210	480
sand	480	520

HARRISON F333

FORMATIONS (Continued)	FROM	TO
RECEIVED		
AUG 16 1990		
Department of Natural Resources Bureau of Land & Water Resources		
IF MORE SPACE IS NEEDED, USE BACK		

If well telescopes please sketch and show depths.

GROUND LEVEL

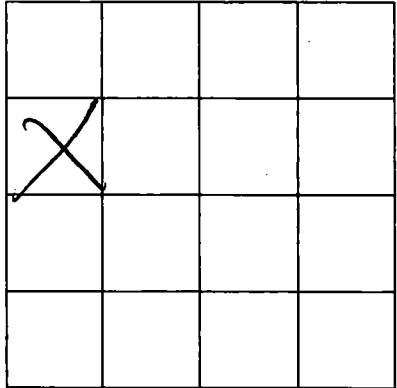

SECTION _____

Please indicate well location X.

ADDITIONAL INFORMATION

220' - 4" PVC
300' - 2" PVC

If more than one screen,
show location of each on sketch.