

# MISSISSIPPI DEPARTMENT OF NATURAL RESOURCES

Bureau of Land and Water Resources

COUNTY WELL LOCATED <b>HARRISON</b>	
WELL NUMBER <b>F 336</b>	CODED <input checked="" type="checkbox"/>
DATE WELL COMPLETED <b>7-14-91</b>	

PERMIT NUMBER <b>0404</b>
NAME OF DRILLING FIRM <b>Hyman Well Co. Inc.</b>
<b>Georgetown MS 39503</b>

**393A** P.O. Box 10631  
Jackson, Mississippi 39209  
**WATER WELL DRILLERS LOG**

NAME & MAILING ADDRESS OF LANDOWNER <b>Bill Stephens</b>		
<b>Georgetown, MS 39503</b>		
<b>Georgetown Rd, Georgetown</b>		
WELL LOCATION: SEC <u>32</u> TOWNSHIP <u>6 N</u> RANGE <u>12 E</u>		
DISTANCE <u>6</u> Miles <u>N</u> of <u>Louisburg</u>		
OTHER LANDMARK		
WELL PURPOSE <input checked="" type="checkbox"/> Home Irrigation, <input type="checkbox"/> Municipal, <input type="checkbox"/> Industrial, <input type="checkbox"/> Fish Pond, etc.		

PUMP DATA		
PUMP TYPE (Circle One): <input checked="" type="checkbox"/> Submersible <input type="checkbox"/> Turbine <input type="checkbox"/> Jet <input type="checkbox"/> Flowing Well, Other (Describe) _____		
POWER TYPE (Circle One): <input checked="" type="checkbox"/> Electric <input type="checkbox"/> Tractor, <input type="checkbox"/> Diesel, <input type="checkbox"/> Gasoline, <input type="checkbox"/> Butane, Other (Describe) _____ H/P _____		
Pump Capacity (GPM) <b>70</b>	No. of Stages <b>6</b>	Setting Depth <b>135</b> FT.
PUMP TEST		
Well yielded _____ GPM with a drawdown of _____ ft. after _____ hours of pumping		

WELL DATA		
Well Depth <b>980</b>	Casing Diameter (In.) <b>4x2</b>	Casing Length (Ft.) <b>960</b>
Type of Casing <b>PVC</b>	Hole Depth <b>580</b>	Depth to Static Water Level <b>57</b>
TYPE OF COMPLETION: (Circle One or More): <input checked="" type="checkbox"/> Gravel Packed, <input checked="" type="checkbox"/> Underreamed, <input type="checkbox"/> Telescoped, <input checked="" type="checkbox"/> Natural Development, <input type="checkbox"/> Open Hole, <input type="checkbox"/> Other (Describe) _____		
Top of Lap Pipe or Reduction in Casing  <b>FEET</b> IF TELESCOPED OR MORE THAN ONE SCREEN: USE BACK PAGE		

LOG DATA	
TYPE OF LOG RUN (Circle One): <input checked="" type="checkbox"/> Electric, <input type="checkbox"/> Gamma Ray, <input type="checkbox"/> Density, <input type="checkbox"/> Sonic, <input type="checkbox"/> Neutron, Other (Describe) _____	
Name of Organization Running Log	

SCREEN DATA		
Diameter - Inches <b>2"</b>	Length - Feet <b>20</b>	Slot Size - Inches <b>8</b>
Screen Type <b>Sawed PVC</b>	Depth to Bottom - Feet <b>980</b>	

GEOLOGIC DATA (Office Use Only)			
Surface Elev.	Geologic Unit	Unit Thickness	Depth to Top
Subs. SWL	Date	Analysis	Aquifer Test
Driller's Remarks			


DESCRIPTION OF FORMATIONS ENCOUNTERED	FORMATIONS (Continued)	
	FROM	TO
Top Soil	0	2
Yellow clay & sand	2	65
Blue clay	65	180
Sand	180	210
<del>20-2-2</del> Clay	210	720
Sand / Rusty	720	757
Blue clay	750	805
Sand / medium	805	980

NOV 18 1991

Bureau of Environmental Quality  
Bureau of Land & Water Resources

IF MORE SPACE IS NEEDED, USE BACK

If well telescopes please sketch and show depths.

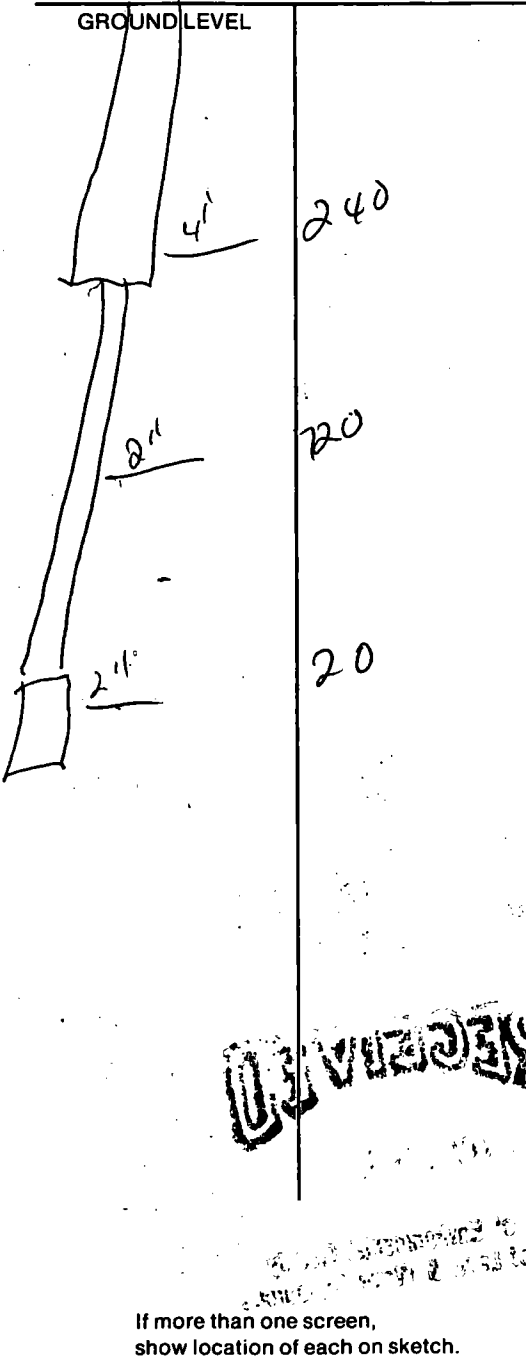


SECTION \_\_\_\_\_

Please indicate well location X.

ADDITIONAL INFORMATION

Lined area for providing additional information.