

If well telescopes please sketch and show depths.


GROUND LEVEL

200 ft
4" PVC
Casing

4.50 PVC
2 inch
Casing

10 ft
PVC
Screen

If more than one screen,
show location of each on sketch.

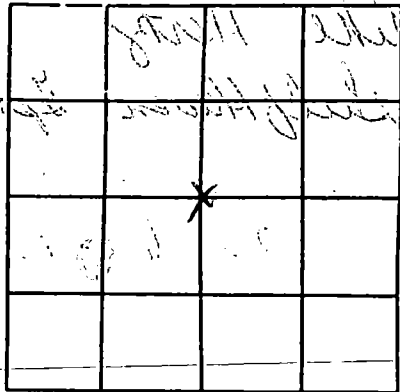

SECTION 12011

Please indicate well location X.

Pump Capacity (GPM) <u>15</u>	No. of Stages <u>2</u>	Setting Depth <u>60</u> FT.
PUMP TEST		
Well yielded <u>15</u> GPM with a drawdown of <u>0</u> ft. after <u>2 2</u> hours of pumping		

LOG DATA

TYPE OF LOG RUN (Circle One): No Log Run.
 Electric, Gamma Ray, Density, Sonic, Neutron.
 Other (Describe) _____

Name of Organization Running Log
DVA

GEOLOGIC DATA (Office Use Only)

Surface Elev.	Geologic Unit	Unit Thickness	Depth to Top
Subs. SWL	Date	Analysis	Aquifer Test

Driller's Remarks
150
