

MISSISSIPPI DEPARTMENT OF ENVIRONMENTAL QUALITY

Office of Land and Water Resources

P. O. Box 10631
Jackson, MS 39289-0631

WATER WELL DRILLERS LOG

COUNTY WELL LOCATED <i>Harrison</i>	
WELL NUMBER F-435	CODED
DATE WELL COMPLETED 1-16-04	

PERMIT NUMBER
NAME OF DRILLING FIRM <i>Crystal Drilling Service Co</i>

NAME & MAILING ADDRESS OF LANDOWNER <i>Mr. Samuel</i>			
<i>John Clark + County Farm</i>			
Latitude:			
Longitude:			
WELL LOCATION	SEC 23	TOWNSHIP 6 N	RANGE 12 E
DISTANCE	DIRECTION	NEAREST TOWN	
Miles	of		
OTHER LANDMARK			
WELL PURPOSE: Home, Irrigation, Municipal, Industrial, Fish Pond, etc. <i>Home</i>			

PUMP DATA		
PUMP TYPE (Circle One): Submersible, Turbine, <u>Jet</u> Flowing Well, Other (Describe) _____		
POWER TYPE (Circle One): Electric, Tractor, Diesel, Gasoline, Butane, Other (Describe) _____ <u>H/P</u>		

DESCRIPTION OF FORMATIONS ENCOUNTERED	FROM	TO
<i>TOP SOIL</i>	<i>1</i>	<i>8</i>
<i>soft blue clay</i>	<i>8</i>	<i>12</i>
<i>black clay</i>	<i>12</i>	<i>50</i>
<i>yellow sand</i>	<i>50</i>	<i>140</i>
<i>hard sand</i>	<i>140</i>	<i>160</i>
<i>loose sand</i>	<i>160</i>	<i>170</i>

WELL DATA:		
Well Depth 170	Casing Diameter (In.) 2"	Casing Length (Ft.) 160
Type of Casing PVC	Hole Depth 170	Depth to Static Water Level 60
TYPE OF COMPLETION: (Circle One or More): Gravel Packed, Underreamed, Telescoped, <u>Natural Development</u> , Open Hole, Other (Describe) _____		
WELL GROUTED TO A DEPTH OF 15 FEET Type Grout (circle one): Cement, Bentonite, or Mix		

SCREEN DATA		
Diameter - inches 2	Length - feet 10	Slot Size - inches .006
Screen Type PVC	Depth to Bottom - Feet 170	

RECEIVED	
FEB 09 2004	
BY: OLWR	
Top of Lap Pipe or Reduction in Casing	IF TELESCOPED OR MORE THAN ONE SCREEN: USE BACK PAGE
FEET	

I certify that the well was drilled, constructed and completed in accordance with all applicable Requirements of the Mississippi Department of Environmental Quality and/or the Mississippi Department of Health regulations and state laws.

Deft Wren
Signature of Licensed Driller and License No. **D-209**

2-4-04
Date

Additional Information Required On Back

If well telescopes please sketch and show depths.


well

1-10-01
 Mr. Jensen
 John Clark + Company

GROUND LEVEL

100' 0"
 100' 0"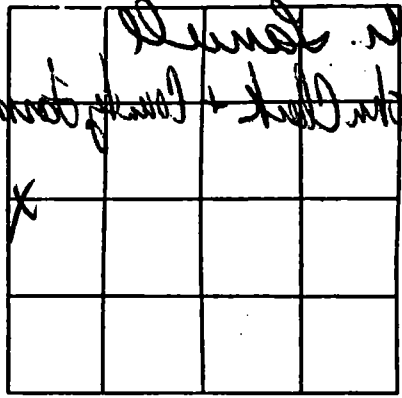
SECTION 100'

Please indicate well location X.

Pump Capacity (GPM)	No. of Stages	Setting Depth
800	2	600'
PUMP TEST		
Well yielded _____ GPM with		
a drawdown of <u>0</u> ft.		
after <u>212</u> hours of pumping		

LOG DATA

TYPE OF LOG RUN (Circle One): No Log Run, Electric, Gamma Ray, Density, Sonic, Neutron, Other (Describe) 2

Name of Organization Running Log 100'

GEOLOGIC DATA (Office Use Only)

Surface Elev.	Geologic Unit	Unit Thickness	Depth to Top
Subs. SWL	Date	Analysis	Aquifer Test

Driller's Remarks

100'-0

100'-0

If more than one screen, show location of each on sketch.