

**MISSISSIPPI DEPARTMENT OF ENVIRONMENTAL
QUALITY**

Office of Land and Water Resources

P. O. Box 10631
Jackson, MS 39289-0631
WATER WELL DRILLERS LOG

COUNTY WELL LOCATED <i>Harrison</i>	
WELL NUMBER F-442	CODED
DATE WELL COMPLETED 3-15-04	

PERMIT NUMBER
NAME OF DRILLING FIRM <i>Coastal Drilling Service Co</i>

NAME & MAILING ADDRESS OF LANDOWNER <i>Mr Pete Fuzer</i>			
<i>20902 Merriette</i>			
Latitude:			
Longitude:			
WELL LOCATION	SEC <i>28</i>	TOWNSHIP <i>4</i>	RANGE <i>12</i>
DISTANCE <i>5 1/2</i> Miles	DIRECTION <i>West</i>	NEAREST TOWN <i>Bayou</i>	
OTHER LANDMARK			
WELL PURPOSE: Home, Irrigation, Municipal, Industrial, Fish Pond, etc. <i>Home</i>			

PUMP DATA		
PUMP TYPE (Circle One): Submersible, Turbine, Jet, <u>Flowing Well</u> , Other (Describe)		
POWER TYPE (Circle One): Electric, Tractor, Diesel, Gasoline, Butane, Other (Describe) <u>H/P</u>		

DESCRIPTION OF FORMATIONS ENCOUNTERED	FROM	TO
<i>Top soil</i>	<i>1</i>	<i>3</i>
<i>silts sand</i>	<i>3</i>	<i>20</i>
<i>red clay</i>	<i>20</i>	<i>125</i>
<i>blue clay</i>	<i>125</i>	<i>180</i>
<i>fine sand</i>	<i>160</i>	<i>180</i>
<i>coarse sand</i>	<i>180</i>	<i>200</i>

WELL DATA		
Well Depth <i>200</i>	Casing Diameter (In.) <i>2"</i>	Casing Length (Ft.) <i>190</i>
Type of Casing <i>PVC</i>	Hole Depth <i>200</i>	Depth to Static Water Level <i>60</i>
TYPE OF COMPLETION: (Circle One or More): Gravel Packed, Underreamed, Telescoped, Natural Development, Open Hole, Other (Describe)		

WELL GROUTED TO A DEPTH OF *15* FEET
Type Grout (circle one): Cement, Bentonite, or Mix

SCREEN DATA		
Diameter - Inches <i>2"</i>	Length - Feet <i>10</i>	Slot Size - Inches <i>.006</i>
Screen Type <i>PVC</i>	Depth to Bottom - Feet <i>200</i>	

Top of Lap Pipe or Reduction in Casing
FEET IF TELESCOPED OR MORE THAN ONE SCREEN: USE BACK PAGE

RECEIVED

APR 07 2004

BY: OLWR

I certify that the well was drilled, constructed and completed in accordance with all applicable Requirements of the Mississippi Department of Environmental Quality and/or the Mississippi Department of Health regulations and state laws.

[Signature] *0-209* *4-2-04*
Signature of Licensed Driller and License No. Date

Additional Information Required On Back


If well telescopes please sketch and show depths.

GROUND LEVEL

188 55
188 55
202 0.7
202 0.7
3-2-04
10-2-1-E
Lateral
Dipole

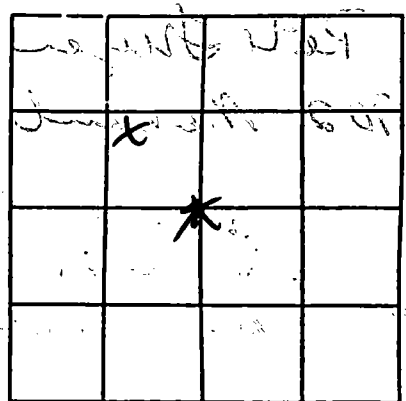

SECTION

Please indicate well location X.

Pump Capacity (GPM) 15	No. of Stages 1	Setting Depth 60 FT.
PUMP TEST		
Well yielded 15 GPM with		
a drawdown of 0 ft.		
after 2 hours of pumping		

LOG DATA

TYPE OF LOG RUN (Circle One): No Log Run, Electric, Gamma Ray, Density, Sonic, Neutron, Other (Describe)

Name of Organization Running Log

GEOLOGIC DATA (Office Use Only)

Surface Elev.	Geologic Unit	Unit Thickness	Depth to Top
Subs. SWL	Date	Analysis	Aquifer Test

Driller's Remarks

0

If more than one screen, show location of each on sketch.

4-2-4

100