

-Jul 11 06 01:15p

Coastal Drilling

2283925031

p. 5

County: Harrison
 Permit #: 0-209
 Driller: R. Mason
 Date drilling completed: 6/15/06

State Well Report
Part I - Driller's Log
 Mississippi Department of Environmental Quality
 Office of Land and Water Resources
 P.O. Box 10631
 Jackson, MS 39289-0631
 (601)961-5210
 (601)354-6938 (fax)

For Office Use Only:
 Aquifer: _____
 Well #: F-471
 L. S. Elevation: _____
 E-log #: _____

State Law requires that this report be prepared by the license holder responsible for the work and filed with the Department at the above address within 30 days of completion of drilling of the well or borehole.

Information on Well Owner <i>(Landowner if borehole is not for a water well)</i> Owner Name: <u>Robert J. Enoch</u> Mailing Address: <u>12885 Hummingbird Lane</u> <u>Gulfport, MS 39501</u> City State Zip Code Telephone No. () _____		Well or Borehole Location Latitude: _____ Longitude: _____ Method of Lat/Long (circle one): Conventional Survey, USGS quad, Hand-held GPS, Survey-grade GPS _____ 1/4 _____ 1/4 Sec. <u>36</u> Twn <u>6S</u> Rng <u>12W</u> Distance Direction Nearest Town <u>2</u> Miles <u>N</u> of <u>Long Beach</u>
Well / Borehole Data Date drilling started: <u>6/14/06</u> Date drilling completed: <u>6/15/06</u> Hole depth: <u>530</u> Hole diameter: <u>4x2</u> Location of the source of any surface water used for drilling: <u>Shed</u> Method of dosing and volume of Chlorine used in drilling and development: <u>1/4th per 1000 gal 89% chlorine</u> Logs run (circle all applicable): No log run <input checked="" type="checkbox"/> Electric <input checked="" type="checkbox"/> Gamma Ray <input type="checkbox"/> Density <input type="checkbox"/> Sonic <input type="checkbox"/> Neutron <input type="checkbox"/> Other: _____ Name of organization running log(s): <u>N/A</u> Purpose of borehole (check one): Water Well <input checked="" type="checkbox"/> Geotechnical/Geological Investigation <input type="checkbox"/> Ground Source Heat Pump _____ Seismic Survey <input type="checkbox"/> Other (describe) _____ <i>If drilling is not related to water well construction, skip the remainder of this block</i>		
Purpose of Well (check one): Home <input checked="" type="checkbox"/> Industrial <input type="checkbox"/> Public Supply <input type="checkbox"/> Irrigation <input type="checkbox"/> Fish Culture <input type="checkbox"/> Other: _____ If a flowing well, method of flow regulation: Valve <u>N/A</u> Other (describe) _____ Static Water Level: <u>8.5</u> feet above or below (circle one) land surface Date measured: <u>6/15/06</u> Method of Measurement (circle one) steel tape electric tape air line other: <u>plumb bob</u> Well depth: <u>530</u> Well grouted to a depth of <u>15</u> feet Type of grout (circle one): Neat Cement <input checked="" type="checkbox"/> Bentonite <input type="checkbox"/> Mix Casing length: <u>520</u> feet Casing diameter: <u>4x2</u> inches Type of casing: <u>PVC</u> Screen length: <u>10</u> feet Screen diameter: <u>4x2</u> inches Type of screen: <u>PVC</u> Screen slot size: <u>.006</u> inches Setting depth: From <u>520</u> feet to <u>530</u> feet Type of completion (circle all applicable): Gravel packed <input type="checkbox"/> Underreamed <input type="checkbox"/> Telescoped <input type="checkbox"/> Open hole <input checked="" type="checkbox"/> Natural Development Other (describe): _____ Top of lap pipe or reduction in casing: <u>N/A</u> feet. <i>If telescoped or more than one screen, describe on next page</i>		


Form: OLWR-SWR-1A

RECEIVED
 JUL 11 2006
 BY: OLWR

F-471

The sketch below only required for water wells

If well telescopes, show depths on sketch

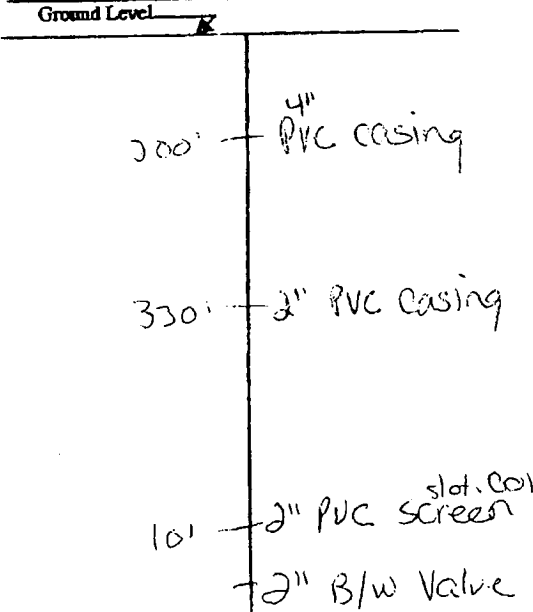

If more than one screen, show location of each on sketch

Description of formations encountered must be provided for all wells and boreholes, unless specifically exempted by regulations

Description of Formations Encountered	From (depth)	To (depth)
	Ground Level	
Top Soil	0	3
Sandy Red clay	3	18
White Sand	18	35
Red sandy Clay	35	45
Soft Blue Clay	45	200
Fine Water Sand	200	230
Soft Blue Clay	230	240
Hard Blue Clay	240	340
Fine White Sand	340	480
Coarse Water Sand	480	530

Sketch the property layout and include the following: 1) the well location; 2) any permanent structures on the property that may aid in locating the well; 3) any roads, power lines, or other items that may aid in locating the property and the well; 4) a north arrow.

Landowner Name: Robert J. Ernochs

Form: OLWR-SWR-1A

I certify that the well/borehole was drilled, constructed, and completed in accordance with all applicable requirements of the Mississippi Department of Environmental Quality and the Mississippi Department of Health regulations, if applicable, and state laws.

Print Name of Responsible Licensee and License No. Dwight Mason 0-209 Date 6/15/06 Signature of Licensee Dwight Mason

RECEIVED
JUL 11 2006
BY: OLWR

STATE WELL REPORT

Part 2

Pump Installer's Completion Report
 Mississippi Department of Environmental Quality
 Office of Land and Water Resources
 P.O. Box 10631
 Jackson, MS 39289-0631
 (601)961-5210
 (601)354-6938 (fax)

County: Harrison
 Permit #: 0-209
 Driller: R. Mason
 Date completed: 6/15/06
Copy information from back on Part 1.

For Office Use Only:
 Aquifer: _____
 Well #: F-471
 Elevation: _____

This part of the report must be completed by a licensed water well contractor or a licensed pump installer. A copy of Part 1 of the report must be attached and both parts filed with the Department at the above address within 30 days of well completion.

Well Owner Information	Well Location
Owner Name: <u>Robert S. Ernochs</u>	Latitude: _____ Longitude: _____
Mailing Address: <u>12385 Hummingbird Lane</u>	Method of Lat/Long (check one): Conventional Survey _____
<u>Culbert MS 39501</u>	USGS quad _____ Hand-held GPS _____ Survey-grade GPS _____
City State Zip Code	_____ 1/4 _____ 1/4 Sec <u>36 T. 14s R. 12w</u>
Telephone No. () _____	Distance Direction Nearest Town
	<u>2 Miles N of Long Beach</u>

Pump Type Circle one	Power Type Circle one
Air Lift <input checked="" type="radio"/> <u>Submersible</u>	Diesel Engine Gasoline Engine Natural Gas
Bucket Piston Turbine	<u>Electric Motor</u> Hand Tractor PTO
Centrifugal Rotary Flowing Well	Windmill Other (specify): _____
Other (specify): _____	Horse Power Rating of Motor: <u>1</u>
Date Pump Installed: <u>6/15/06</u>	Setting Depth: <u>85</u> feet
Rated Pump Capacity: <u>5</u> Gallons Per Minute	Number of Stages: <u>14</u>

Pump Test Data	Method of Measuring Water Level Circle one
Date Well Tested: <u>6/15/06</u>	Air Line Electric Measuring Line Steel Tape
Static Water Level (A): <u>85</u> Feet Below Land Surface	Other (specify): <u>Plumb bob</u>
Pumping Water Level (B): <u>85</u> Feet Below Land Surface	For flowing well, measured shut in head: <u>N/A</u> feet
Drawdown ((B)-(A)): <u>0</u> Feet Below Land Surface	Well yielded <u>15</u> GPM with a drawdown of
Test Pumping Rate: <u>15</u> Gallons Per Minute	<u>0</u> feet after <u>4</u> hours of pumping
Duration of Pump Test (minimum 4 hours): <u>4</u> hours	

I HEREBY CERTIFY that the above statements are true to the best of my knowledge.
Dwight Mason 0-209
 Print Name of Pump Installer and License No. (if applicable) Dwight Mason
 Signature of Pump Installer

Form: OLWR-SWR-1B

RECEIVED
 JUL 11 2006
 BY: OLWR