
Rade "

Never received R.2.3/13 State W	all Domont			
Stute (1	For Office Use Only:			
	briller's Log t of Environmental Quality Aquifer:			
Permit #: Office of Land a	nd Water Resources F- 490			
	Sox 10631			
Jackson, M	IS 39289-0631 L. S. Elevation: 961-5210			
Bute driving compression	4-6938 (fax) E-log #:			
State Law requires that this report be prepared by the license holder responsible for the work and filed with the Department at the above address within 30 days of completion of drilling of the well or borehole.				
Information on Well Owner	Well or Borehole Location			
(Landowner if borehole is not for a water well)	Latitude 30 .30 .203" Longitude 9 . 1/ . 357			
Owner Name AL SARDSA	Method of Lat/Long (circle one): Conventional Survey, 21			
Mailing Address 43D 5-1 hL Rd.				
	USGS quid, Hand-held GPS, Survey-grade GPS SE 4.5E 1/4 Sec 21 Twn 6.5 Rng 12 pr			
GPT MS 37550	SE 4. SE 4 Sec A Twn 6 S Rng 12 4			
City State Zip Code	Distance Direction Nearest Town <u>Miles WEST of GUIFDON</u>			
Telephone No. ()				
Well / Borehole Data				
Date drilling started: 11/12/0 Bate drilling completed: 11/12 Hole depth: 176 Hole diameter:				
Location of the source of any surface water used for drilling:				
Method of dosing and volume of Chlorine used in drilling and development:				
Logs run (circle all applicable): No log ron Electric Gamma Ray Density Sonic Neutron Other:				
Purpose of borehole (check one): Water Wett Geotechnical/Geological Investigation Ground Source Heat Pump				
Seismic Survey Other (<i>describe</i>) If drilling is not related to water well construction, skip the remainder of this block				
Purpose of Well (check one): HomeIndustrial Public Supply Irrigation Fish Culture Other:				
If a flowing well, method of flow regulation: Valve Other (describe)				
Static Water Level: <u>63</u> feet above or below (circle one) land surface Date measured: <u>11/12/07</u>				
Method of Measurement (circle one) steel tape electric tape air line other:				
Well depth: 26 Well grouted to a depth of feet Type of grout (circle one): Neat Cement Benionite Mix				
Casing length: <u>66</u> feet Casing diameter: <u>7</u> inches Type of casing: <u>100</u>				
Screen length: <u>20</u> feet Screen diameter: <u>2</u> inches Type of screen: <u>12</u>				
Screen slot size: <u>OCC</u> _inches Setting depth: From <u>166</u> feet to <u>176</u> feet				
Type of completion (circle all applicable): Gravel packed Underreamed Telescoped Open hole Natural Development				
Other (describe):				
Top of lap pipe or reduction in casing:feet. If telescoped or more than one screen, describe on next page				
	Form: OLWR-SWR-1/			

RECEIVED NOV 27 2007 BY: OLWR

E-490


The sketch below only required for water wells

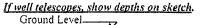

<u>Description of formations encountered must be provided for all</u> wells and boreholes, unless specifically exempted by regulations

~~~~~~~~~~~~~~~~~~~~~~~~~~~~~~~~~~~~~~~	Description of Formations Encountered		To (depth)
	clar	Ground Level	70
	Spiral	21	110
	(h)	1/7	
		100	
	1102		1
	0.110		
		VP7	
		-	
		,	<u> </u>
~			
			L
· ·			
			1
×			<u> </u>

If more than one screen, show location of each on sketch

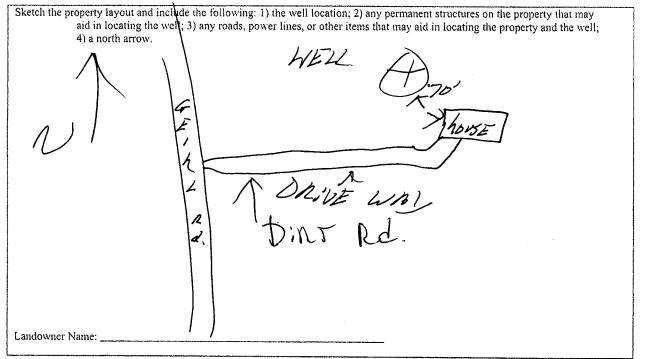

Form: OLWR-SWR-1A

I certify that the well/borehole was drilled, constructed, and completed in accordance with all applicable requirements of the Mississippi Department of Environmental Quality and the Mississippi Department of Health regulations, if applicable, and state

laws. Schull2

Print Name of Responsible Licensee and License No.

Date

Signature of Licensee