

State Well Report

Part 1 - Driller's Log

Mississippi Department of Environmental Quality
Office of Land and Water Resources
P.O. Box 10631
Jackson, MS 39289-0631
(601)961-5210
(601)354-6938 (fax)

For Office Use Only:

Aquifer: _____
Well #: F-492
L. S. Elevation: _____
E-log #: _____

County: Harrison
Permit #: _____
Driller: 0-785
Date drilling completed: 12-5-07

State Law requires that this report be prepared by the license holder responsible for the work and filed with the Department at the above address within 30 days of completion of drilling of the well or borehole.

Information on Well Owner (Landowner if borehole is not for a water well)	Well or Borehole Location
Owner Name: <u>Dot Hershey</u>	Latitude: <u>N 30° 20' 781"</u> Longitude: <u>W 89° 11' 044"</u>
Mailing Address: <u>20422</u>	Method of Lat/Long (circle one): Conventional Survey, <u>47</u>
<u>Meaganite Rd.</u>	USGS quad, <u>Hand-held GPS</u> , Survey-grade GPS
<u>Gpt.</u> <u>Ms.</u> <u>39503</u>	<u>Nw 1/4</u> <u>Nw 1/4</u> Sec <u>22</u> Twn <u>6S</u> Rng <u>12W</u>
City _____ State _____ Zip Code _____	Distance _____ Miles Direction _____ of Nearest Town _____
Telephone No. (____) <u>0</u> _____	

Well / Borehole Data

Date drilling started: 12-5 Date drilling completed: 12-5 Hole depth: 380' Hole diameter: 5"

Location of the source of any surface water used for drilling: _____
Method of dosing and volume of Chlorine used in drilling and development: _____

Logs run (circle all applicable): No log run Electric Gamma Ray Density Sonic Neutron Other: _____
Name of organization running log(s): _____

Purpose of borehole (check one): Water Well Geotechnical/Geological Investigation _____ Ground Source Heat Pump _____
Seismic Survey _____ Other (describe) _____

If drilling is not related to water well construction, skip the remainder of this block

Purpose of Well (check one): Home Industrial _____ Public Supply _____ Irrigation _____ Fish Culture _____ Other: _____

If a flowing well, method of flow regulation: Valve _____ Other (describe) _____

Static Water Level: 100 feet above or below (circle one) land surface Date measured: 12-5-07

Method of Measurement (circle one) steel tape electric tape air line other: _____

Well depth: 380' Well grouted to a depth of 15 feet 200' / 160' Type of grout (circle one): Neat Cement Bentonite Mix

Casing length: 360 feet Casing diameter: 3" / 2" inches Type of casing: PVC

Screen length: 20 feet Screen diameter: 2 inches Type of screen: PVC

Screen slot size: .006 inches Setting depth: From 360' feet to 380' feet

Type of completion (circle all applicable): Gravel packed Underreamed Telescoped Open hole Natural Development
Other (describe): _____

Top of lap pipe or reduction in casing: _____ feet. **If telescoped or more than one screen, describe on next page**

Form: OLWR-SWR-1A

RECEIVED


JAN 07 2008

BY: OLWR

The sketch below only required for water wells

Description of formations encountered must be provided for all wells and boreholes, unless specifically exempted by regulations

If well telescopes, show depths on sketch.

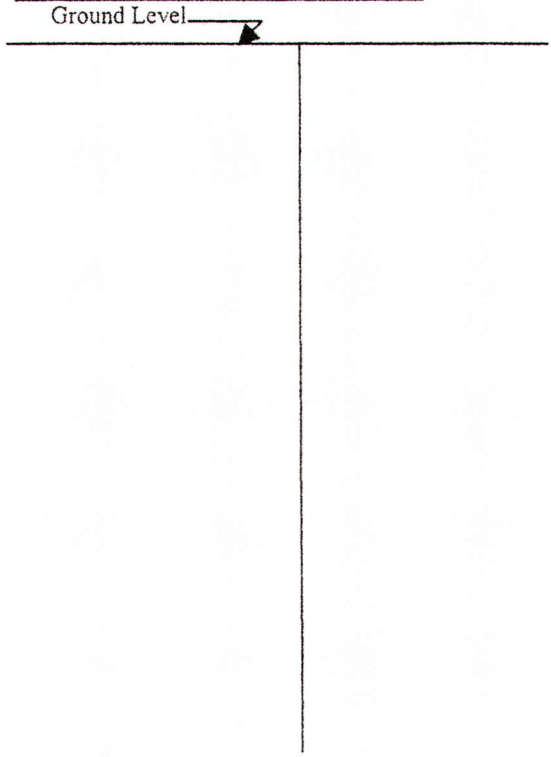

Description of Formations Encountered	From (depth)	To (depth)
Clay	Ground Level	15'
Sand	15'	125'
Clay	125'	290'
Sand	290'	305'
Clay	305'	355'
Sand	355'	380'

If more than one screen, show location of each on sketch

Sketch the property layout and include the following: 1) the well location; 2) any permanent structures on the property that may aid in locating the well; 3) any roads, power lines, or other items that may aid in locating the property and the well; 4) a north arrow.

Landowner Name: Dot Hershey

RECEIVED
JAN 07 2008
BY: OLWR

I certify that the well/borehole was drilled, constructed, and completed in accordance with all applicable requirements of the Mississippi Department of Environmental Quality and the Mississippi Department of Health regulations, if applicable, and state laws.

MAUVIN WAGNON 0-785 12-5-09 Martin Wagon
 Print Name of Responsible Licensee and License No. Date Signature of Licensee

STATE WELL REPORT

Part 2

Pump Installer's Completion Report
 Mississippi Department of Environmental Quality
 Office of Land and Water Resources
 P.O. Box 10631
 Jackson, MS 39289-0631
 (601)961-5210
 (601)354-6938 (fax)

County: Harrison
 Permit #: _____
 Driller: P-795
 Date completed: 12-10-07
Copy information from block on Part 1

For Office Use Only:

Aquifer: _____
 Well #: F-492
 Elevation: _____

This part of the report must be completed by a licensed water well contractor or a licensed pump installer. A copy of Part 1 of the report must be attached and both parts filed with the Department at the above address within 30 days of well completion.

Well Owner Information	Well Location
Owner Name: <u>Dot Hershey</u>	Latitude: <u>N 30° - 30.791'</u> Longitude: <u>W 89° - 11.044'</u>
Mailing Address: <u>20422</u> <u>Minnowite Rd</u>	Method of Lat/Long (check one): Conventional Survey _____ USGS quad <u>Hand-held GPS</u> , Survey-grade GPS _____
<u>6pt.</u> <u>Ms.</u> <u>39503</u> City State Zip Code	_____ ¼ _____ ¼ Sec _____ T _____ R _____
Telephone No. (____) <u>Ø</u>	Distance _____ Direction _____ Nearest Town _____ _____ Miles _____ of _____

Pump Type Circle one	Power Type Circle one
Air Lift Jet <input type="radio"/> Submersible <input checked="" type="radio"/>	Diesel Engine Gasoline Engine Natural Gas
Bucket Piston Turbine <input type="radio"/> Electric Motor <input checked="" type="radio"/>	Hand Tractor PTO
Centrifugal Rotary Flowing Well	Windmill Other (specify): _____
Other (specify): _____	Horse Power Rating of Motor: <u>1.5</u>
Date Pump Installed: <u>12-10</u>	Setting Depth: <u>140</u> feet
Rated Pump Capacity: <u>15</u> Gallons Per Minute	Number of Stages: _____

Pump Test Data	Method of Measuring Water Level Circle one
Date Well Tested: <u>12-10-07</u>	Air Line Electric Measuring Line <input checked="" type="radio"/> Steel Tape <input type="radio"/>
Static Water Level (A): <u>100</u> Feet Below Land Surface	Other (specify): _____
Pumping Water Level (B): <u>140</u> Feet Below Land Surface	For flowing well, measured shut in head: _____ feet
Drawdown [(B) - (A)]: <u>40</u> Feet Below Land Surface	Well yielded _____ GPM with a drawdown of _____ feet after _____ hours of pumping
Test Pumping Rate: _____ Gallons Per Minute	
Duration of Pump Test (minimum 4 hours): <u>24</u> hours	

I HEREBY CERTIFY that the above statements are true to the best of my knowledge.

REGGIE PETERMAN P795 _____
 Print Name of Pump Installer and License No. (if applicable) Signature of Pump Installer

Form: OLWR-SWR-1B

RECEIVED
 JAN 07 2008
 BY: OLWR