County: Haccison	State Well Report Part 1 – Driller's Log	For Office Use Only:
County	Mississippi Department of Environmental Quality	Aquifer:
Permit #:	Office of Land and Water Resources	F-496
Driller: 0-785	P.O. Box 10631	Well #:
	Jackson, MS 39289-0631	L. S. Elevation:
Date drilling completed: 4-2-08	(601)961-5210	
	(601)354-6938 (fax)	E-log #:

1

\*

State Law requires that this report be prepared by the license holder responsible for the work and filed with the Department at the above address within 30 days of completion of drilling of the well or borehole.

Information on Well Owner	Well or Borehole Location					
(Landowner if borehole is not for a water well)	20 20 20 000 000 11 020					
Owner Name William Mckay / Didi Wahl	Latitude: <u>30 ° 30 '057</u> " Longitude: <u>99 ° 11 '239</u> " 03 Method of Lat/Long (circle one): Conventional Survey,					
Mailing Address:						
Mennonite Rol.	USGS quad Hand-held GPS, Survey-grade GPS					
Got - pls. 2903 City State Zip Code	Distance Direction Nearest Town					
Telephone No. () 223 - 5~944	Miles of					
Well / Bore	chole Data					
Date drilling started: <u>4-2</u> Date drilling completed: <u>4-2</u> Hole depth: <u>140</u> Hole diameter: <u>5</u>						
Location of the source of any surface water used for drilling:						
Method of dosing and volume of Chlorine used in drilling and deve	lopment:					
Logs run (circle all applicate): No log run Electric Gamma Ray Density Sonic Neutron Other:						
Purpose of borehole (check one): Water Well Geotechnical/Geological Investigation Ground Source Heat Pump						
Seismic SurveyOther ( <i>describe</i> )						
If drilling is not related to water well construction						
Purpose of Well (check one): Home / Industrial Public Supply	yIrrigationFish CultureOther:					
If a flowing well, method of flow regulation: Valve O	Other (describe)					
Static Water Level:						
Method of Measurement (circle one) steel tape electric tape air line other:						
Well depth: 140 Well grouted to a depth of 15 feet Type of grout (circle one) Neat Cement Bentonite Mix						
Casing length: <u>150</u> feet Casing diameter: <u>2</u> inches Type of casing: <u>PVC</u>						
Screen length: <u>10</u> feet Screen diameter: <u>2</u> inches Type of screen: <u><i>PVC</i></u>						
Screen slot size:,006inches Setting depth: Fromfeet tofeet tofeet						
Type of completion (circle all applicable): Gravel packed Underreamed Telescoped Open hole Natural Development						
Other (describe):						
Top of lap pipe or reduction in casing:feet. If telescoped or more than one screen, describe on next page						

Form: OLWR-SWR-1A

APR 2 9 2008 BY: OLWR

F-496


The sketch below only required for water wells

If well telescopes, show depths on sketch. Ground Level

## Description of formations encountered must be provided for all wells and boreholes, unless specifically exempted by regulations

Description of Formations Encountered	From (depth)	(depth)
Clav	Ground Level	20
Sand	20	30
Clay	30	140
Sand	140	160

If more than one screen, show location of each on sketch

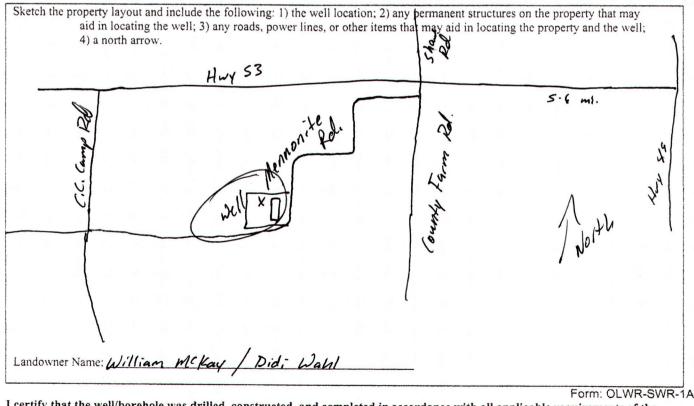

I certify that the well/borehole was drilled, constructed, and completed in accordance with all applicable requirements of the Mississippi Department of Environmental Quality and the Mississippi Department of Health regulations, if applicable, and state laws.

MALVIN WAGNOW 0-785 4-2-08

Mal- Wages APR 2 9 2008 Signature of Licensee BY: OLWR

Print Name of Responsible Licensee and License No.

Date

STATE WELL REPORT					
Permit #:		<i>at the above address within 30 da</i> Well	nys of well completion. Location		
Owner Name: William Millay Did: Wohl Mailing Address: Mennonite RD, Gpt. Ms. 39503 City State Zip Code Telephone No. () 223 - 5944		Latitude: <u>30°. 30.057</u> Longitude: <u>SF° - 11, 237</u> ' Method of Lat/Long (check one): Conventional Survey, USGS quad, Hand-held GPS, Survey-grade GPS '4'4_ SecTR Distance Direction Nearest Town Milesof			
Pump Type Circle one    Air Lift  Image: Circle one    Bucket  Piston    Centrifugal  Rotary    Other (specify):		Cir Diesel Engine Gasoline Electric Motor Hand	feet		
Pump Test Data    Date Well Tested:  4-3-08    Static Water Level (A):  40    Feet Below Land Surface    Pumping Water Level (B):  70    Feet Below Land Surface    Drawdown [(B) - (A)]:  30    Feet Below Land Surface    Test Pumping Rate:  Gallons Per Minute    Duration of Pump Test (minimum 4 hours):  24		Method of Measuring Water Level Circle one    Air Line  Electric Measuring Line    Other (specify):			
I HEREBY CERTIFY that the above statements are true to the best of my knowledge. <u>MALVIN</u> <u>MAGNON</u> <u>O-705</u> Print Name of Pump Installer and License No. (if applicable) Signature of Pump Installer					

¢.

•

Form: OLWR-SUPECEIVED

APR 2 9 2008 BY OLWE