

MISSISSIPPI DEPARTMENT OF NATURAL RESOURCES

Bureau of Land and Water Resources

Southport Mall

P.O. Box 10631

Jackson, Mississippi 39209

WATER WELL DRILLERS LOG

COASTAL DRILLING & SERVICE CO.

Harrison
F
2000

5/27/63
 date well completed

ROUTE 1 BOX 618
 farm name

Harrison
 county well located

BILOXI MISS. 39532

Tommy McKay
 LANDOWNER
Hill top road
Spt. W
 (mailing address)

description of formations encountered

from to

WELL LOCATION:
 sec 21 T 6 S R 12 W
None South Hwy 53
 (distance) miles (direction) (nearest town)

description of formations encountered	from	to
<u>topsoil</u>	<u>1</u>	<u>3</u>
<u>Yellow Clay</u>	<u>3</u>	<u>16</u>
<u>Orange white sand</u>	<u>16</u>	<u>45</u>
<u>Soft Blue Clay</u>	<u>45</u>	<u>60</u>
<u>Super Sand</u>	<u>60</u>	<u>95</u>
<u>Soft Blue Clay</u>	<u>95</u>	<u>210</u>
<u>fine white sand</u>	<u>210</u>	<u>230</u>
<u>hard blue clay</u>	<u>230</u>	<u>310</u>
<u>fine white sand</u>	<u>310</u>	<u>330</u>
<u>good water sand</u>	<u>330</u>	<u>360</u>

WELL PURPOSE: none
 (home, irrigation, municipal, industrial)

WELL COMPLETION DATA:
 (1) diameter (inches) 2"
 (2) total depth (feet) 360'
 (3) static water level (feet) 50' below top of ground.
 (4) casing pk 350'
 (material) (depth)
 (size) if telescope see back.
 (5) screen 10' 350'
 (length) (depth to top)
2" pk
 (size) (material)
 (6) pump None 12
 (HP) (yield gpm)
ele
 (type power)
 (7) electric log no
 (yes or no)
 (organization running log)
2" back wash valve
 (8) how well bottom plugged 19-6

DEPT. OF NATURAL RESOURCES
 BUREAU OF LAND & WATER RESOURCES


APR - 5 1964

RECEIVE

DRILLERS REMARKS:

If well telescopes please sketch and show depths.

GROUND LEVEL

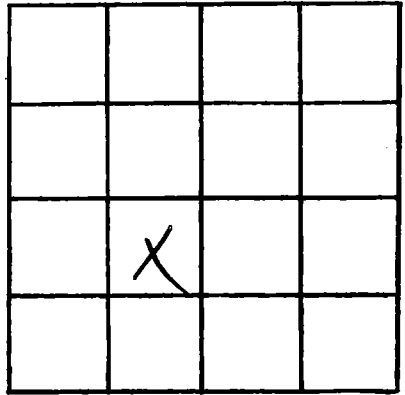

SECTION _____

Please indicate well location X.

ADDITIONAL INFORMATION

If more than one screen, show locations of each on sketch.