

MISSISSIPPI DEPARTMENT OF NATURAL RESOURCES

Bureau of Land and Water Resources

Southport Mall

P.O. Box 10631

Jackson, Mississippi 39209

WATER WELL DRILLERS LOG

Harrison
F 2005

5/4/84 19 Bradley Pump + Well Serv Harrison
 date well completed fish name county well located

LANDOWNER:	description of formations encountered	from	to
<u>Walter J. Messin</u>	<u>sand + clay</u>	<u>0</u>	<u>20</u>
<u>Rt. 1, Box 470 B</u>	<u>blue clay</u>	<u>20</u>	<u>40</u>
<u>Saucier, Ms. 39574</u>	<u>blue clay - sand breaks</u>	<u>40</u>	<u>60</u>
(mailing address)	<u>tan sand</u>	<u>60</u>	<u>80</u>
WELL LOCATION:	<u>brown sand</u>	<u>80</u>	<u>100</u>
sec. <u>3</u> T. <u>6</u> S. R. <u>12</u> E. W.	<u>rusty sand + clay</u>	<u>100</u>	<u>120</u>
<u>2 1/2</u> miles <u>W.</u> of <u>Wortham</u>	<u>sand</u>	<u>120</u>	<u>140</u>
(distance) (direction) (nearest town)	<u>green sand</u>	<u>140</u>	<u>220</u>
WELL PURPOSE: <u>Home</u>			
(home, irrigation, municipal, industrial)			
WELL COMPLETION DATA:			
(1) diameter (inches) <u>2"</u>			
(2) total depth (feet) <u>220</u>			
(3) static water level (feet) <u>21</u> below top of ground.			
(4) casing <u>PVC</u> <u>187'</u> (material) (depth)			
<u>2"</u> (size) If telescope see back.			
(5) screen <u>18'</u> <u>187'</u> (length) (depth to top)			
<u>2"</u> (size) <u>PVC underborer</u> (material)			
(6) pump <u>1</u> <u>10</u> (HP) (yield gpm)			
<u>230V</u> (type power)			
(7) electric log <u>no</u> (yes or no)			
(organization running log)			
(8) how well bottom plugged <u>PVC</u>			
<u>Sandshark</u>			
DRILLERS REMARKS: <u>15'</u>			
<u>tailpipe</u>			


DEPT. OF NATURAL RESOURCES
 BUREAU OF LAND & WATER RESOURCES

MAY 17 1984

RECEIVED

If well telescopes please sketch and show depths.

GROUND LEVEL

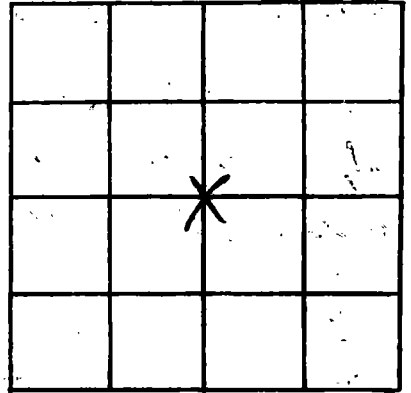

SECTION 3

Please indicate well location X.

ADDITIONAL INFORMATION

If more than one screen, show locations of each on sketch.