

MISSISSIPPI DEPARTMENT OF NATURAL RESOURCES

Bureau of Land and Water Resources

Southport Mall

P.O. Box 10631

Jackson, Mississippi 39209

WATER WELL DRILLERS LOG
COASTAL DRILLING & SERVICE CO.

ROUTE 1 BOX 618

firm name

BILOXI, MISS. 39532

county well located

Harrison
F
208

date well completed

19

LANDOWNER

Herb Miller

description of formations encountered

from

to

Turnin Taked

top soil

1

3

P.O. Box 3162 Hat MS
(mailing address)

Red Clay

3

20

Coarse white sand

20

45

Soft Blue Clay

45

120

Sugar Sand

120

135

Salt Blue Clay

135

145

Yellow Water Sand

145

170

WELL LOCATION:

sec. 3 T. 6 N. R. 12 E

Little Billie, MS

(distance) (direction) of (nearest town)

WELL PURPOSE:

(home, irrigation, municipal, industrial)

None

WELL COMPLETION DATA:

- (1) diameter (inches) 2"
- (2) total depth (feet) 170
- (3) static water level (feet) 65' below top of ground.

- (4) casing PVC, 100'
(material) (depth)

(size) if telescope see back.

- (5) screen 10', 100'
(length) (depth to top)

2", PVC
(size) (material)

- (6) pump None, 10
(HP) (yield gpm)

440
(type power)

- (7) electric log Yes
(yes or no)

(organization running log)

- (8) how well bottom plugged Value

DRILLERS REMARKS: 19-B


DEPT. OF NATURAL RESOURCES
BUREAU OF LAND & WATER RESOURCES

JUN 28 1971

RECEIVED

If well telescopes please sketch and show depths.

GROUND LEVEL

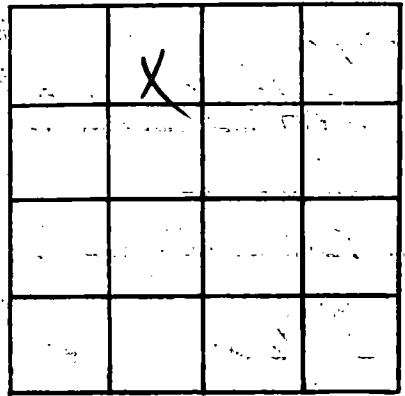

SECTION _____

Please indicate well location X.

ADDITIONAL INFORMATION

If more than one screen,
show locations of each on sketch.