

MISSISSIPPI DEPARTMENT OF NATURAL RESOURCES

Bureau of Land and Water Resources

Southport Mall

P.O. Box 10631

Jackson, Mississippi 39209

WATER WELL DRILLERS LOG

HARRISON
F 2009

6-9-84
date well completed

McGill Well Works
firm name

HARRISON
county well located

LANDOWNER: <u>Kirby Anderson</u>	Description of formations encountered	from	to
<u>Rt. 1 Box 614</u>			
<u>Lancien, Mo</u> (mailing address)	<u>Mud</u> <u>Mud & SAND</u> <u>SAND</u>	<u>0</u> <u>160</u> <u>180</u>	<u>160</u> <u>180</u> <u>190</u>
WELL LOCATION:			
sec. <u>1</u> T. <u>4</u> N. R. <u>12</u> E. <u>7</u> miles <u>S</u> of <u>Sen</u> (distance) (direction) (nearest town)			
WELL PURPOSE: <u>home</u> (home, irrigation, municipal, industrial)			
WELL COMPLETION DATA:			
(1) diameter (inches) <u>2"</u>			
(2) total depth (feet) <u>190'</u>			
(3) static water level (feet) <u>60'</u> <u>below</u> top of ground <u>above</u>			
(4) casing <u>2" PVC</u> <u>180'</u> (material) (depth)			
(size) If telescope see back.			
(5) screen <u>10'</u> <u>180'</u> (length) (depth to top)			
<u>2"</u> <u>sch 50</u> (size) (material)			
(6) pump <u>1/2</u> <u>9</u> (HP) (yield gpm)			
<u>elec</u> (type power)			
(7) electric log _____ (yes or no)			
_____ (organization running log)			
(8) how well bottom plugged <u>Seal</u>			
DRILLERS REMARKS:			


DEPT. OF NATURAL RESOURCES
BUREAU OF LAND & WATER RESOURCES

JUL 10 1984

RECEIVED

If well telescopes please sketch and show depths.

GROUND LEVEL

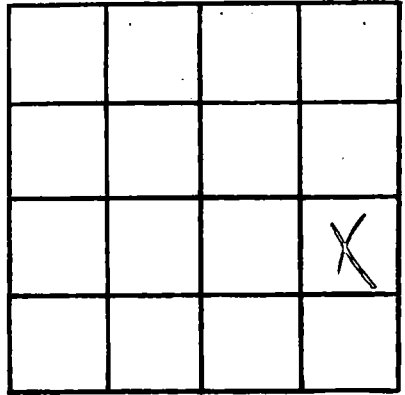

SECTION 1

Please indicate well location X.

ADDITIONAL INFORMATION

If more than one screen, show locations of each on sketch.