

MISSISSIPPI DEPARTMENT OF NATURAL RESOURCES  
Bureau of Land and Water Resources  
Southport Mall  
P.O. Box 10631  
Jackson, Mississippi 39209  
WATER WELL DRILLERS LOG

Harrison  
F 2010

6/12/84 19 Lyman Well Co. Harrison  
date well completed, firm name county well located

LANDOWNER: Steve Kelly  
#18 Joy Ridge  
Gulfport 39503  
(mailing address)

WELL LOCATION:  
sec. 3 T. 6 N. R. 12 E.  
12 miles n/w of Cpt  
(distance) (direction) (nearest town)

WELL PURPOSE: Home  
(home, Irrigation, municipal, Industrial)

- WELL COMPLETION DATA:
- (1) diameter (inches) 2"
  - (2) total depth (feet) 381'
  - (3) static water level (feet) 65 below above top of ground.
  - (4) casing Pvc, 371',  
(material) (depth)  
2" If telescope see back.  
(size)
  - (5) screen 10', 371'  
(length) (depth to top)  
2", PVC  
(size) (material)
  - (6) pump 1 1/2, 13 1/2  
(HP) (yield gpm)  
electric  
(type power)
  - (7) electric log No  
(yes or no)  
No  
(organization running log)
  - (8) how well bottom plugged sand  
shark

description of formations encountered	from	to
Red sand	0	60
White Clay	60	100
Grey Clay	100	140
Blue Clay	140	250
fine sand	250	300
Blue Clay	300	340
medium sand	340	381

DEPT. OF NATURAL RESOURCES  
BUREAU OF LAND & WATER RESOURCES


SEP - 5 1984

RECEIVED

DRILLERS REMARKS:

If well telescopes please sketch and show depths.

GROUND LEVEL

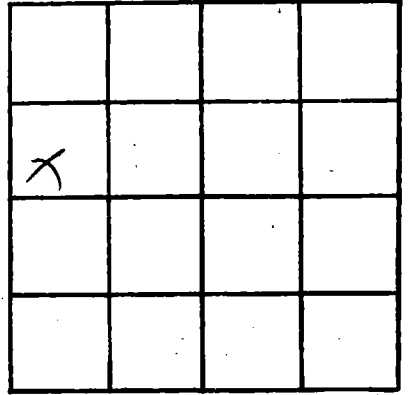

SECTION 3

Please indicate well location X.

ADDITIONAL INFORMATION

If more than one screen, show locations of each on sketch.