

MISSISSIPPI DEPARTMENT OF NATURAL RESOURCES

Bureau of Land and Water Resources

Southport Mall

P.O. Box 10631

Jackson, Mississippi 39209

WATER WELL DRILLERS LOG

Harrison
F
2011

7-24-84 19 McGill Pump & Wells Harrison
 date well completed firm name county well located

LANDOWNER: Mickey Lo...
 Rt. 1 Box 1015
 Saucier, Mo.
 (mailing address)

WELL LOCATION:
 sec. 1 T. 6 N. R. 12 E.
 S. W.
 7 miles S of Sec.
 (distance) (direction) (nearest town)

WELL PURPOSE: Home
 (home, irrigation, municipal, industrial)

WELL COMPLETION DATA:
 (1) diameter (inches) 2"
 (2) total depth (feet) 190'
 (3) static water level (feet) 60' below top of ground.
 (4) casing 4" PVC 180' (material) (depth)
 -0- (size) If telescope see back.
 (5) screen 10' 180' (length) (depth to top)
 2" mesh 6 slot (size) (material)
 (6) pump 1 9 (HP) (yield gpm)
 elec (type power)
 (7) electric log -0- (yes or no)
 -0- (organization running log)
 (8) how well bottom plugged Seal

Description of formations encountered	from	to
clay	0	20
sand & mud	20	40
clay	40	120
sand & mud	120	140
clay	140	160
sand	160	190


DEPT. OF NATURAL RESOURCES
 BUREAU OF LAND & WATER RESOURCES

OCT - 4 1984
 RECEIVED

DRILLERS REMARKS:

If well telescopes please sketch and show depths.

GROUND LEVEL

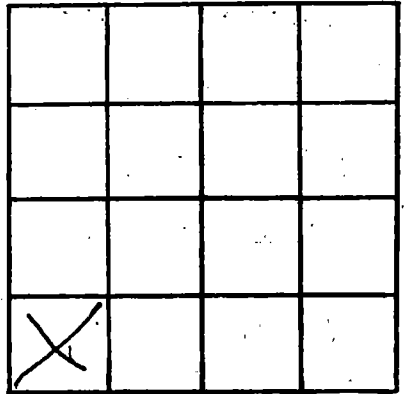

SECTION _____

Please indicate well location X.

ADDITIONAL INFORMATION

If more than one screen, show locations of each on sketch.