

BOARD OF WATER COMMISSIONERS

416 North State Street

Jackson, Mississippi 39201

WATER WELL DRILLERS LOG

Harrison

F 2013

11-30-84 date well completed

R. J. Maden firm name

HARRISON county well located

LANDOWNER: PRES. W. Maden

Box 165 C-C - ROAD

Outsprint, MS (mailing address)

WELL LOCATION:

sec. 2 T. 6 N. R. 12 E. of LITANA (distance) (direction) (nearest town)

WELL PURPOSE: (home, irrigation, municipal, industrial)

WELL COMPLETION DATA:

- (1) diameter (inches) 2"
(2) total depth (feet) 188'
(3) static water level (feet) 40' below top of ground
(4) casing (material) PVC (depth) 188'
(5) screen (length) 18', (depth to top) 188'
(6) pump (HP) (yield gpm)
(7) electric log (yes or no)
(8) how well bottom plugged BCW

description of formations encountered

from to

TOP SOIL 10 20
white & red clay 20 50
white clay 50 110
red sand 110 140
white clay 140 160
coarse sand 160 188

DEPT. OF NATURAL RESOURCES BUREAU OF LAND & WATER RESOURCES


DEC - 6 1984

DRILLERS REMARKS:

RECEIVED

If well telescopes please sketch and show depths.

GROUND LEVEL

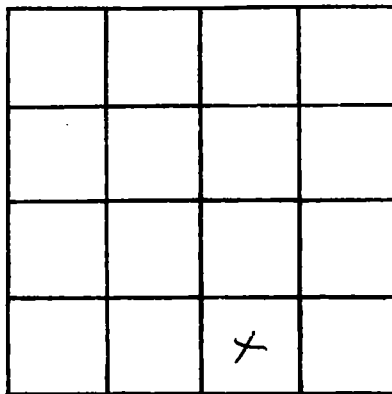

SECTION _____

Please indicate well location X.

ADDITIONAL INFORMATION

If more than one screen,
show locations of each on sketch.