

MISSISSIPPI DEPARTMENT OF NATURAL RESOURCES

Bureau of Land and Water Resources

Southport Mall

P.O. Box 10631

Jackson, Mississippi 39209

WATER WELL DRILLERS LOG  
COASTAL DRILLING & SERVICE CO.

ROUTE 1 BOX 618

BILOXI MISS. 39532

*Hanson*  
F 2014

*6/4/84*  
date well completed

*Hanson*  
county well located

LANDOWNER

*Walter W. Miller*

description of formations encountered

from to

*PO Box 3162*

<i>Top Soil</i>	<i>1</i>	<i>4</i>
<i>Red Clay</i>	<i>4</i>	<i>15</i>
<i>Coarse white Sand</i>	<i>15</i>	<i>30</i>
<i>Soft Blue Clay</i>	<i>30</i>	<i>45</i>
<i>Coarse white Sand</i>	<i>45</i>	<i>60</i>
<i>Soft Blue Clay</i>	<i>60</i>	<i>140</i>
<i>Good water Sand</i>	<i>140</i>	<i>170</i>

*apt ms*

(mailing address)

WELL LOCATION:

sec. *3* T. *6* N. R. *12* E.

*11 North Little Bilek Lane*  
(distance) *1 1/2* miles (direction) *S* of (nearest town) *Jenifer*

WELL PURPOSE:

(home, irrigation, municipal, industrial)

*None*

WELL COMPLETION DATA:

- (1) diameter (inches) *2"*
- (2) total depth (feet) *120'*
- (3) static water level (feet) *60'* below above top of ground.
- (4) casing *PVC*, *160'* (material) (depth)

(size) If telescope see back.

- (5) screen *10'*, *160'* (length) (depth to top)
- 2"* (size) *PVC* (material)

- (6) pump *None*, *10* (HP) (yield gpm)
- Ele* (type power)

- (7) electric log *Yes* (yes or no)

(organization running log)

- (8) has well bottom plugged

*Shack With Valve*  
*19-13*

DRILLERS REMARKS:


DEPT OF NATURAL RESOURCES  
BUREAU OF LAND & WATER RESOURCES

NOV 16 1984

RECEIVED

If well telescopes please sketch and show depths.

GROUND LEVEL

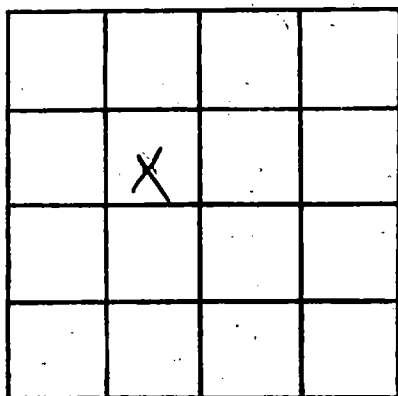

SECTION \_\_\_\_\_

Please indicate well location X.

ADDITIONAL INFORMATION

If more than one screen, show locations of each on sketch.