

MISSISSIPPI DEPARTMENT OF NATURAL RESOURCES

Bureau of Land and Water Resources

Southport Mall

P.O. Box 10631

Jackson, Mississippi 39209

WATER WELL DRILLERS LOG

Harrison
F
205

8/20/84 19 Lyman Well Co. Harrison
 date well completed firm name county well located

LANDOWNER: <u>Paul Ladner</u>	description of formations encountered	from	to
<u>Rt. 2, Box 148-H</u>	<u>yellow & red clay</u>	<u>0</u>	<u>15</u>
<u>Gulfport, Miss 39503</u> (mailing address)	<u>white clay w/ yellow sand</u>	<u>16</u>	<u>184</u>
WELL LOCATION: sec <u>18</u> T <u>6</u> N R <u>12</u> E <u>10</u> miles <u>NW</u> of <u>Ept</u> (distance) (direction) (nearest town)	<u>Sand</u>	<u>185</u>	<u>204</u>
WELL PURPOSE: <u>None</u> (home, irrigation, municipal, industrial)			
WELL COMPLETION DATA:			
(1) diameter (inches) <u>2"</u>			
(2) total depth (feet) <u>204</u>			
(3) static water level (feet) <u>80'</u> <u>below</u> top of ground.			
(4) casing <u>PVC</u> , <u>194'</u> (material), (depth)			
<u>2"</u> (size) if telescope see back.			
(5) screen <u>10'</u> , <u>194'</u> (length), (depth to top)			
<u>2"</u> , <u>PVC</u> (size), (material)			
(6) pump <u>1 1/2</u> , <u>12</u> (HP), (yield gpm)			
<u>electric</u> (type power)			
(7) electric log <u>No</u> (yes or no)			
<u>No</u> (organization running log)			
(8) how well bottom plugged <u>sand</u> <u>Shark</u>			
DRILLERS REMARKS:			


DEPT. OF NATURAL RESOURCES
 BUREAU OF LAND & WATER RESOURCES

DEC 10 1984

RECEIVED

If well telescopes please sketch and show depths.

GROUND LEVEL

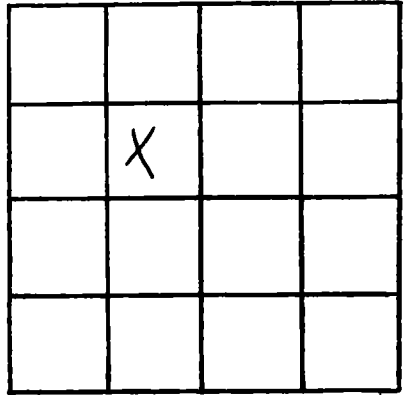

SECTION 18

Please indicate well location X.

ADDITIONAL INFORMATION

If more than one screen, show locations of each on sketch.