

MISSISSIPPI DEPARTMENT OF NATURAL RESOURCES

Bureau of Land and Water Resources

Southport Mall ¹⁴

P.O. Box 10631

Jackson, Mississippi 39209

WATER WELL DRILLERS LOG

Harrison
F 2016

8/27/84 19 Lyman Well Co Harrison
 date well completed firm name county well located

LANDOWNER	Description of formations encountered	from	to
<u>Hazel McDowell</u>	<u>Yellow clay</u>	<u>0</u>	<u>20</u>
<u>Rt. 2, Box 140</u>	<u>blue clay</u>	<u>21</u>	<u>194</u>
<u>Gulfport, Miss 39503</u> (mailing address)	<u>sand</u>	<u>195</u>	<u>194</u>
WELL LOCATION:			
sec. <u>8</u> T. <u>6</u> N. R. <u>12</u> E			
<u>1.5</u> miles <u>NW</u> of <u>Brt</u>			
(distance) (direction) (nearest town)			
WELL PURPOSE: <u>Home</u>			
(home, irrigation, municipal, industrial)			
WELL COMPLETION DATA:			
(1) diameter (inches) <u>2"</u>			
(2) total depth (feet) <u>194'</u>			
(3) static water level (feet) <u>65</u> ^{below} above top of ground.			
(4) casing <u>PVC</u> , <u>184'</u>			
(material) (depth)			
<u>2"</u> If telescope see back.			
(size)			
(5) screen <u>10'</u> , <u>184'</u>			
(length) (depth to top)			
<u>2"</u> , <u>PVC</u>			
(size) (material)			
(6) pump <u>N/A</u>			
(HP) (yield gpm)			
(type power)			
(7) electric log <u>No</u>			
(yes or no)			
<u>No</u>			
(organization running log)			
(8) how well bottom plugged <u>sand</u>			
<u>shark</u>			
DRILLERS REMARKS:			


DEPT. OF NATURAL RESOURCES
 BUREAU OF LAND & WATER RESOURCES

DEC 10 1984

RECEIVED

If well telescopes please sketch and show depths.

GROUND LEVEL

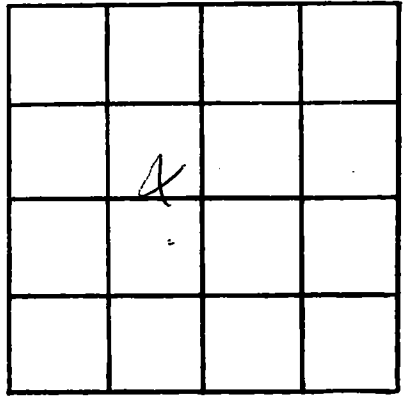

SECTION 8

Please indicate well location X.

ADDITIONAL INFORMATION

If more than one screen, show locations of each on sketch.