

MISSISSIPPI DEPARTMENT OF NATURAL RESOURCES
Bureau of Land and Water Resources
 Southport Mall
 P.O. Box 10631
 Jackson, Mississippi 39209
WATER WELL DRILLERS LOG

Harrison
F 209

11/10/84 19 Lyman Well Co. Harrison
 date well completed firm name county well located

LANDOWNER: W.W. Green
Saucier Lyzina Rd.
Saucier, MS 39574
 (mailing address)

WELL LOCATION:
 sec. 7 T. 6 N. R. 12 E.
3 miles NE of Lyzina
 (distance) (direction) (nearest town)

WELL PURPOSE: Home
 (home, irrigation, municipal, industrial)

- WELL COMPLETION DATA:
- (1) diameter (inches) 4 x 2
- (2) total depth (feet) 300'
- (3) static water level (feet) 41 below above top of ground.
- (4) casing PVC 280'
 (material) (depth)
4x2 if telescope see back.
 (size)
- (5) screen 20' 280'
 (length) (depth to top)
2" PVC
 (size) (material)
- (6) pump N/A _____
 (HP) (yield gpm)
 (type power) _____
- (7) electric log NO
 (yes or no)
NO
 (organization running log)
- (8) how well bottom plugged sand
Shark

description of formations encountered	from	to
<u>mud - blue</u>	<u>0</u>	<u>20</u>
<u>sand, yellow</u>	<u>20</u>	<u>80</u>
<u>blue mud</u>	<u>80</u>	<u>240</u>
<u>sandy mud</u>	<u>240</u>	<u>260</u>
<u>sand</u>	<u>260</u>	<u>300</u>



DRILLERS REMARKS: _____

DEPT. OF NATURAL RESOURCES
 BUREAU OF LAND & WATER RESOURCES
 DEC 17 1984

RECEIVED

If well telescopes please sketch and show depths.

GROUND LEVEL

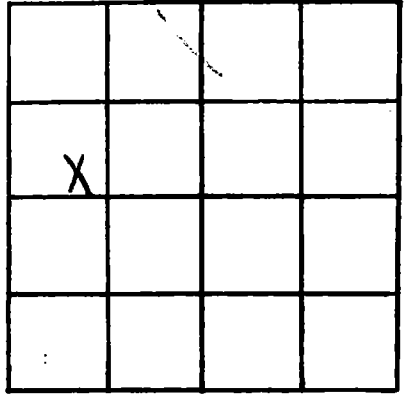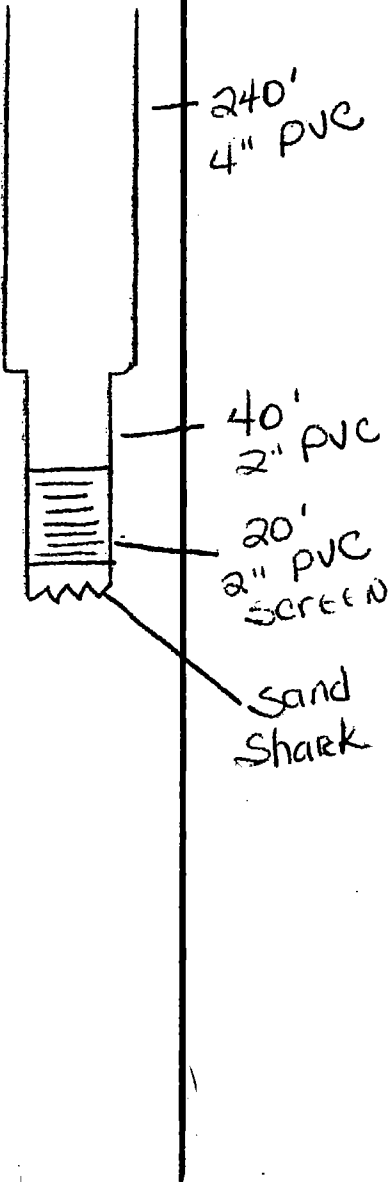

SECTION 7

Please indicate well location X.

ADDITIONAL INFORMATION

Lined area for additional information.

If more than one screen, show locations of each on sketch.