

MISSISSIPPI DEPARTMENT OF NATURAL RESOURCES

Bureau of Land and Water Resources

Southport Mall

P.O. Box 10631

Jackson, Mississippi 39209

WATER WELL DRILLERS LOG

F 2020
Harrison
1222-84

12/22/84

date well completed

19 Lyman Well Co.

firm name

Harrison

county well located

LANDOWNER:

Richard Thyrock

Rt. 4, Box 336

Pass Christian, MS 39511

(mailing address)

description of formations encountered

from

to

top soil

0

10

Blue clay

10

395

Course sand

395

410

WELL LOCATION:

sec. 2 T. 8 N. R. 12 E.
3 miles N of Pineville
(distance) (direction) (nearest town)

WELL PURPOSE:

(home, irrigation, municipal, industrial)

Home

WELL COMPLETION DATA:

(1) diameter (inches) 4 1/2"
(2) total depth (feet) 410'
(3) static water level (feet) 6 below above top of ground.

(4) casing PVC, 400'
(material) (depth)
2"
(size) if telescope see back.

(5) screen 10', 400'
(length) (depth to top)
2", PVC
(size) (material)

(6) pump 1, 13
(HP) (yield gpm)
electric
(type power)

(7) electric log NO
(yes or no)
NO
(organization running log)


(8) how well bottom plugged Sand
Shark

DRILLERS REMARKS:

1-17-85
RW

If well telescopes please sketch and show depths.

GROUND LEVEL

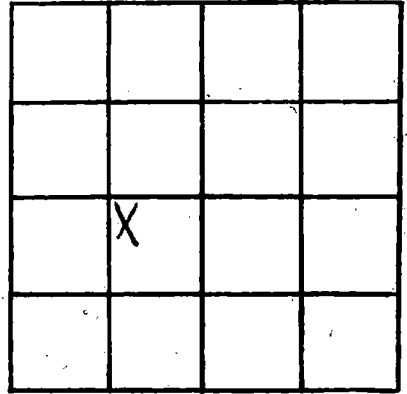

SECTION 6

Please indicate well location X.

ADDITIONAL INFORMATION

If more than one screen,
show locations of each on sketch.