

MISSISSIPPI DEPARTMENT OF NATURAL RESOURCES

Bureau of Land and Water Resources

Southport Mall

P.O. Box 10631

Jackson, Mississippi 39209

WATER WELL DRILLERS LOG

HARRISON  
F 7021

3/9/85 date well completed  
Lyman Well firm name  
Harrison county well located

LANDOWNER: Jessie Smith  
P.O. Box 1977  
Gulfport, MS 39502  
(mailing address)

description of formations encountered	from	to
red clay	0	60
blue clay	60	340
fine sand	340	360
coarse sand	360	380

WELL LOCATION:  
sec. 11 T. 6 N R. 12 E  
10 miles N.W. of Gulfport  
(distance) (direction) (nearest town)

WELL PURPOSE: Home  
(home, irrigation, municipal, industrial)

WELL COMPLETION DATA:

(1) diameter (inches) 2"

(2) total depth (feet) 380'

(3) static water level (feet) 67' below above top of ground.

(4) casing PVC, 370'  
(material) (depth)  
2" if telescope see back.  
(size)


(5) screen 10', 370'  
(length) (depth to top)  
2" PVC  
(size) (material)

(6) pump 1 10  
(HP) (yield gpm)  
Electric  
(type power)

(7) electric log NO  
(yes or no)  
NO  
(organization running log)

(8) how well bottom plugged sand  
shark


DRILLERS REMARKS:

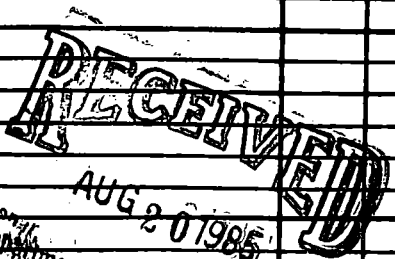

Mississippi Department of Natural Resources  
Bureau of Land & Water Resources

If well telescopes please sketch and show depths.

GROUND LEVEL

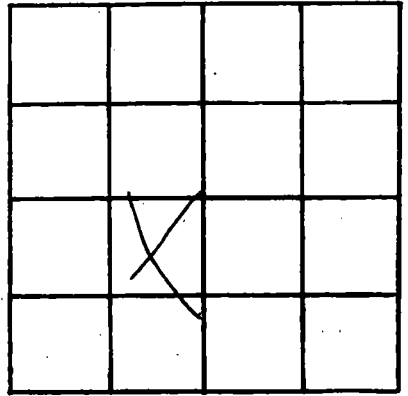

SECTION 11

Please indicate well location X.

ADDITIONAL INFORMATION

If more than one screen, show locations of each on sketch.