

**Harrison**  
**F 2022**  
**4-2-85**

MISSISSIPPI DEPARTMENT OF NATURAL RESOURCES  
 Bureau of Land and Water Resources  
 Southport Mall  
 P.O. Box 10631  
 Jackson, Mississippi 39209  
**WATER WELL DRILLERS LOG**

4-2 1985 Mc Hill Pump Well Harrison  
 date well completed firm name county well located

LANDOWNER: James Houston  
Rt 1 Box 198  
Southport, Mo.  
 (mailing address)

WELL LOCATION:  
 sec. 33 T. 6 N. R. 12 E  
 (S) (W)  
 (distance) miles (direction) of (nearest town)

WELL PURPOSE:  
 (home, irrigation, municipal, industrial)

WELL COMPLETION DATA:

(1) diameter (inches) 2"

(2) total depth (feet) 400'

(3) static water level (feet) 30' below above top of ground.

(4) casing Pvc Sch 40 290'  
 (material) (depth)  
 (size) if telescope see back.

(5) screen 10' 390'  
 (length) (depth to top)  
2" Sch 80 - 60st  
 (size) (material)

(6) pump 1 8  
 (HP) (yield gpm)  
Elec.  
 (type power)

(7) electric log yes or no  
 (organization running log)

description of formations encountered	from	to
<u>Mud/Sand</u>	<u>0</u>	<u>20</u>
<u>Sand/mud</u>	<u>20</u>	<u>40</u>
<u>Mud</u>	<u>40</u>	<u>120</u>
<u>Mud/Sand</u>	<u>120</u>	<u>160</u>
<u>Sand (rusty)</u>	<u>160</u>	<u>200</u>
<u>Sand/Mud</u>	<u>200</u>	<u>220</u>
<u>Mud</u>	<u>220</u>	<u>240</u>
<u>Mud/Sand</u>	<u>240</u>	<u>260</u>
<u>Mud</u>	<u>260</u>	<u>280</u>
<u>Mud/Sand</u>	<u>280</u>	<u>300</u>
<u>Mud</u>	<u>300</u>	<u>360</u>
<u>Sand</u>	<u>360</u>	<u>400</u>

**RECEIVED**  
 JUN 11 1985


Department of Natural Resources  
 Bureau of Land & Water Resources

(8) how well bottom plugged Sand  
SHARK

DRILLERS REMARKS:

If well telescopes please sketch and show depths.

GROUND LEVEL

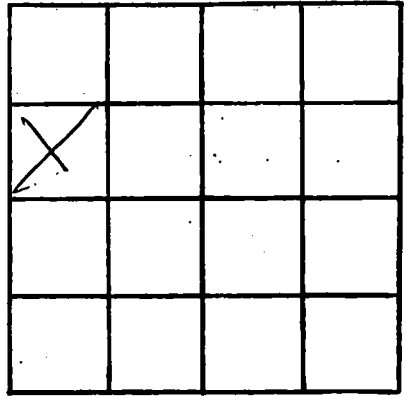

SECTION \_\_\_\_\_

Please indicate well location X.

ADDITIONAL INFORMATION

If more than one screen, show locations of each on sketch.