

Harrison

F 2023

4-17-85

MISSISSIPPI DEPARTMENT OF NATURAL RESOURCES
 Bureau of Land and Water Resources
 Southport Mall
 P.O. Box 10631
 Jackson, Mississippi 39209
WATER WELL DRILLERS LOG

4-17

1985

Mc Hill Well Works Harrison

date well completed

firm name

county well located

LANDOWNER: Musiel Wildaush

Rt. 2 Box 125 Cumers

Southport Mo. 39503
(mailing address)

WELL LOCATION:

sec. 17 T. 6 N R. 12 E
 (distance) miles (direction) of (nearest town)
15 miles NW of SOUTHPORT

WELL PURPOSE:

(home, irrigation, municipal, industrial)

WELL COMPLETION DATA:

- (1) diameter (inches) 2"
- (2) total depth (feet) 600'
- (3) static water level (feet) 50' ^{below} _{above} top of ground.
- (4) casing Pvc Sch 40 590'
(material) (depth)

(size) if telescope see back.

- (5) screen 10' 590'
(length) (depth to top)
- 2" Sch 80 6 slot
(size) (material)

- (6) pump 1 8
(HP) (yield gpm)

Elec
(type power)

- (7) electric log _____
(yes or no)

(organization running log)

- (8) how well bottom plugged SAND SHACK

DRILLERS REMARKS:


description of formations encountered	from	to
Mud	0	40
mud/sand	40	100
mud	100	140
Mud/sand	140	180
Sand/mud	180	200
mud	200	280
Mud/sand	280	320
Mud	320	340
Sand/mud	340	360
Mud	360	480
Mud/sand	480	500
Mud	500	520
Mud/sand	520	540
Sand	540	600

RECEIVED
 JUN 11 1985

Department of Natural Resources
 Bureau of Land and Water Resources

If well telescopes please sketch and show depths.

GROUND LEVEL

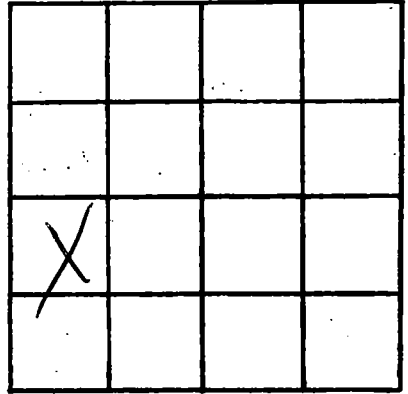

SECTION _____

Please indicate well location X.

ADDITIONAL INFORMATION

If more than one screen, show locations of each on sketch.