

MISSISSIPPI DEPARTMENT OF NATURAL RESOURCES
Bureau of Land and Water Resources
 Southport Mall
 P.O. Box 10631
 Jackson, Mississippi 39209
WATER WELL DRILLERS LOG

Harrison
F 2024
5-18-85

5-18 1985 McHiel Well Works Harrison
 date well completed firm name county well located

LANDOWNER: Bertico Stegall
Old Highway 49
Soucie, Ms
 (mailing address)

| Description of formations encountered | Description of formations encountered | |
|---------------------------------------|---------------------------------------|-----|
| | from | to |
| Mud | 0 | 100 |
| Mud/Sand | 100 | 120 |
| Sand/Mud | 120 | 140 |
| Mud | 140 | 180 |
| Mud/Sand | 180 | 200 |
| Sand | 200 | 240 |

WELL LOCATION:
 sec. 24 T. 6 N. R. 12 E.
 (S) (W)
4 miles NW of LYMAN
 (distance) (direction) (nearest town)

WELL PURPOSE:
 (home, irrigation, municipal, industrial)

- WELL COMPLETION DATA:
- diameter (inches) 2"
 - total depth (feet) 240'
 - static water level (feet) 50' below above top of ground.
 - casing Pvc. Sch 40 230'
 (material) (depth)
 (size) if telescope see back.
 - screen 10' 230'
 (length) (depth to top)
2" Sch 80 6 slot
 (size) (material)
 - pump 1 7
 (HP) (yield gpm)
ELCC
 (type power)
 - electric log _____
 (yes or no)

 (organization running log)
 - how well bottom plugged SAND
SHARK

RECEIVED


JUN 11 1985

DRILLERS REMARKS: _____

Department of Natural Resources
 Bureau of Land & Water Resources

If well telescopes please sketch and show depths.

GROUND LEVEL

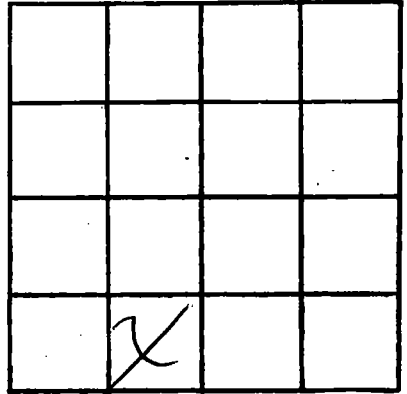

SECTION _____

Please indicate well location X.

ADDITIONAL INFORMATION

If more than one screen, show locations of each on sketch.