

MISSISSIPPI DEPARTMENT OF NATURAL RESOURCES

Bureau of Land and Water Resources

Southport Mall

P.O. Box 10631

Jackson, Mississippi 39209

WATER WELL DRILLERS LOG

HARRISON  
F 2025

5/21/85 19 Lyman Well Co Harrison  
date well completed firm name county well located

LANDOWNER: James K Ammons Jr  
Clark Rd.  
Gulfport, MS 39503  
(mailing address)

description of formations encountered	from	to
Red clay	0	40
Blue clay	40	313
Sandstone	313	323

WELL LOCATION:  
sec. 27 T 6 N R 12 E  
0 miles N of Longleaf  
(distance) (direction) (nearest town)

WELL PURPOSE: Home Use  
(home, irrigation, municipal, industrial)

WELL COMPLETION DATA:

(1) diameter (inches) 2"

(2) total depth (feet) 323'

(3) static water level (feet) 48' below top of ground.

(4) casing PVC 313' (material) (depth)  
2" (size) If telescope see back.

(5) screen 10' 313' (length) (depth to top)  
2" (size) PVC (material)

(6) pump 1 (HP) 12 (yield gpm)  
electric (type power)

(7) electric log No (yes or no)  
No (organization running log)

(8) how well bottom plugged Sand Shark


RECEIVED  
AUG 2 0 1985

Department of Natural Resources  
Bureau of Land & Water Resources

DRILLERS REMARKS:

If well telescopes please sketch and show depths.

GROUND LEVEL

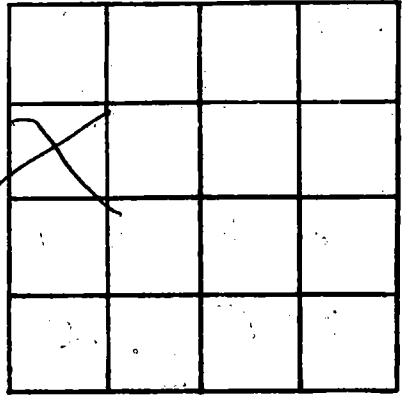

SECTION 27

Please indicate well location X.

ADDITIONAL INFORMATION

If more than one screen, show locations of each on sketch.