

Harrison
F. 2026
5/13/85

MISSISSIPPI
BOARD OF WATER COMMISSIONERS
416 North State Street
Jackson, Mississippi 39201
WATER WELL DRILLERS LOG

5-13-85 19 R.T. Moore HARRISON
date well completed firm name county well located

LANDOWNER: Roy J. Sande Sec
LIZIANA School RD
P.O. 3775
Culbertson, MS, 39505
(mailing address)

WELL LOCATION:
sec. 18 T. 6 N. R. 12 E.
1/2 miles N of Liziana School
(distance) (direction) (nearest town)

description of formations encountered	from	to
Top Soil	0	10
Blue & white clay	10	100
Blue Clay	100	290
Coarse Gravelly sand	290	320

WELL PURPOSE:
(home) Irrigation, municipal, industrial


- WELL COMPLETION DATA:
- (1) diameter (inches) 2"
 - (2) total depth (feet) 320'
 - (3) static water level (feet) 60' ^{below} _{above} top of ground.
 - (4) casing PVC 320'
(material) (depth)
 - (size) If telescope see back.
 - (5) screen 10' 320'
(length) (depth to top)
 - 2" PVC
(size) (material)
 - (6) pump 1 6
(HP) (yield gpm)
 - E
(type power)
 - (7) electric log (yes or no)
 - (organization running log)
 - (8) how well bottom plugged Good

RECEIVED
JUN - 1 1985

DRILLERS REMARKS:

If well telescopes please sketch and show depths.

GROUND LEVEL

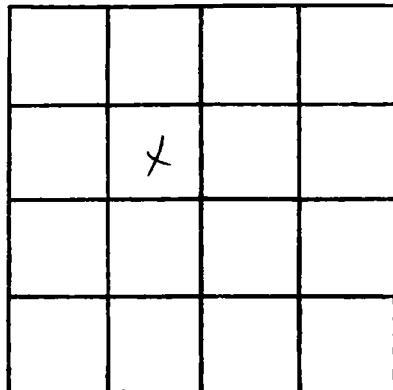

SECTION 18

Please indicate well location X.

ADDITIONAL INFORMATION

If more than one screen, show locations of each on sketch.