

**MISSISSIPPI DEPARTMENT OF NATURAL RESOURCES**  
**Bureau of Land and Water Resources**  
 Southport Mall  
 P.O. Box 10631  
 Jackson, Mississippi 39209  
**WATER WELL DRILLERS LOG**

Harrison  
F 2029  
5-23-85

5-23-85 19 Mc Hill Well Works Harrison  
 date well completed firm name county well located

LANDOWNER: Leanneth Mayfield  
Rt 2 Box 127N  
Subport, Mo 38503  
 (mailing address)

WELL LOCATION:  
 sec. 17 T. 6 N R. 12 E  
5 miles NW of Subport  
 (distance) (direction) (nearest town)

WELL PURPOSE:  
 (home, irrigation, municipal, industrial)

WELL COMPLETION DATA:

(1) diameter (inches) 2"

(2) total depth (feet) 220'

(3) static water level (feet) 40 below top of ground. above

(4) casing Sch. 40 PVC, 210'  
 (material) (depth)  
 (size) If telescope see back.

(5) screen 10', 210'  
 (length) (depth to top)  
2", Sch. 80  
 (size) (material)

(6) pump 1 8  
 (HP) (yield gpm)  
Elec.  
 (type power)

(7) electric log NO  
 (yes or no)  
 (organization running log)

(8) how well bottom plugged Seal


description of formations encountered	from	to
Mud-Sand	0	20
Mud-Sand	20	40
Mud	40	60
Mud	60	80
Mud	80	100
Mud	100	120
Mud	120	140
Mud	140	160
Mud	160	180
Mud	180	200
Sand	200	220

**RECEIVED**  
 JUN 11 1985

DRILLERS REMARKS:

If well telescopes please sketch and show depths.

GROUND LEVEL

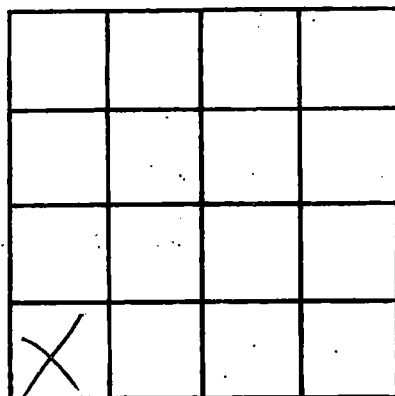

SECTION \_\_\_\_\_

Please indicate well location X.

ADDITIONAL INFORMATION

If more than one screen, show locations of each on sketch.