

MISSISSIPPI DEPARTMENT OF NATURAL RESOURCES

Bureau of Land and Water Resources

Southport Mall

P.O. Box 10631

Jackson, Mississippi 39209

WATER WELL DRILLERS LOG
COASTAL DRILLING & SERVICE CO.

Harrison
F 2030
Co-6-84

6/6/84
date well completed 19

Rt. 11, Box 81

Harrison
county well located

LANDOWNER: Allstate Insurance

MS 39532

description of formations encountered

from to

mary Avenue
Pass Christian, MS
(mailing address)

top soil	1	3
red clay	3	20
sugar sand	20	50
stiff blue clay	50	190
hard blue clay	190	320
course white sand	320	340
blue clay	340	420
fine water sand	420	430
good water sand	430	440

WELL LOCATION:

sec 19 T 6 N R 12 E
S W
Pass Christian
(distance) miles (direction) (nearest town)

WELL PURPOSE: municipal
(home, irrigation, municipal, industrial)

WELL COMPLETION DATA:

- (1) diameter (inches) 2"
- (2) total depth (feet) 440
- (3) static water level (feet) 10 below top of ground
- (4) casing PVC, 430 (material) (depth)
- (size) if telescope see back.
- (5) screen 10', 430' (length) (depth to top)
- 2" PVC (size) (material)
- (6) pump 1 (HP) 789 (yield gpm)
- elec. (type power)
- (7) electric log no (yes or no)

(organization running log)

(8) how well bottom plugged 2" back wash well 19-B

DRILLERS REMARKS:


RECEIVED

JUL 22 1985

Department of Natural Resources
Bureau of Land & Water Resources

If well telescopes please sketch and show depths.

GROUND LEVEL

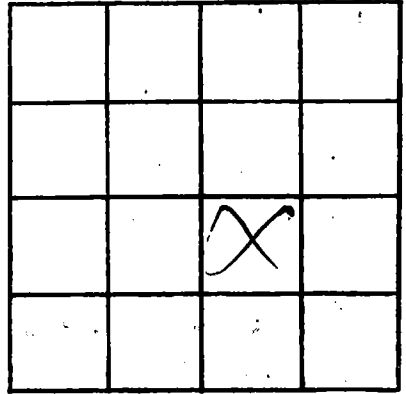

SECTION _____

Please indicate well location X.

ADDITIONAL INFORMATION

If more than one screen, show locations of each on sketch.