

MISSISSIPPI DEPARTMENT OF NATURAL RESOURCES

Bureau of Land and Water Resources

Southport Mall

P.O. Box 10631

Jackson, Mississippi 39209

WATER WELL DRILLERS LOG

HARRISON
F 2032

7-30 19 95 Mc Hill Pump & Well Harrison
 date well completed firm name county well located

LANDOWNER: Lisby Anderson
Rt. 1 Box 614 Bert Rd
Sauvier, Mo. 39574
 (mailing address)

description of formations encountered	depth	
	from	to
<u>Mud</u>	<u>0</u>	<u>20</u>
<u>Mud/Sand</u>	<u>20</u>	<u>40</u>
<u>Mud</u>	<u>40</u>	<u>160</u>
<u>Mud/Sand</u>	<u>160</u>	<u>180</u>
<u>Sand</u>	<u>180</u>	<u>190</u>

WELL LOCATION:

sec. 25 T. 6 N R. 12 E
3 miles SE of Lyman
 (distance) (direction) (nearest town)

WELL PURPOSE:

(home, irrigation, municipal, industrial)

WELL COMPLETION DATA:

- (1) diameter (inches) 2"
- (2) total depth (feet) 190'
- (3) static water level (feet) 23 ^{below} _{above} top of ground.
- (4) casing Sch 40 Pvc 180'
 (material) (depth)
 (size) if telescope see back.
- (5) screen 10' 180'
 (length) (depth to top)
2" Sch 40 solid PVC
 (size) (material)
- (6) pump 1 8
 (HP) (yield gpm)
Elec.
 (type power)
- (7) electric log
 (yes or no)

(organization running log)

(8) how well bottom plugged SAND
SHARK


DRILLERS REMARKS:

RECEIVED
 AUG 20 1985

Department of Natural Resources
 Bureau of Land & Water Resources

If well telescopes please sketch and show depths.

GROUND LEVEL

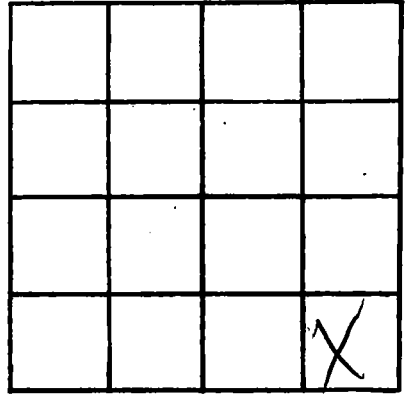

SECTION _____

Please indicate well location X.

ADDITIONAL INFORMATION

If more than one screen, show locations of each on sketch.